


T.11-12S.R.43E.W.M.

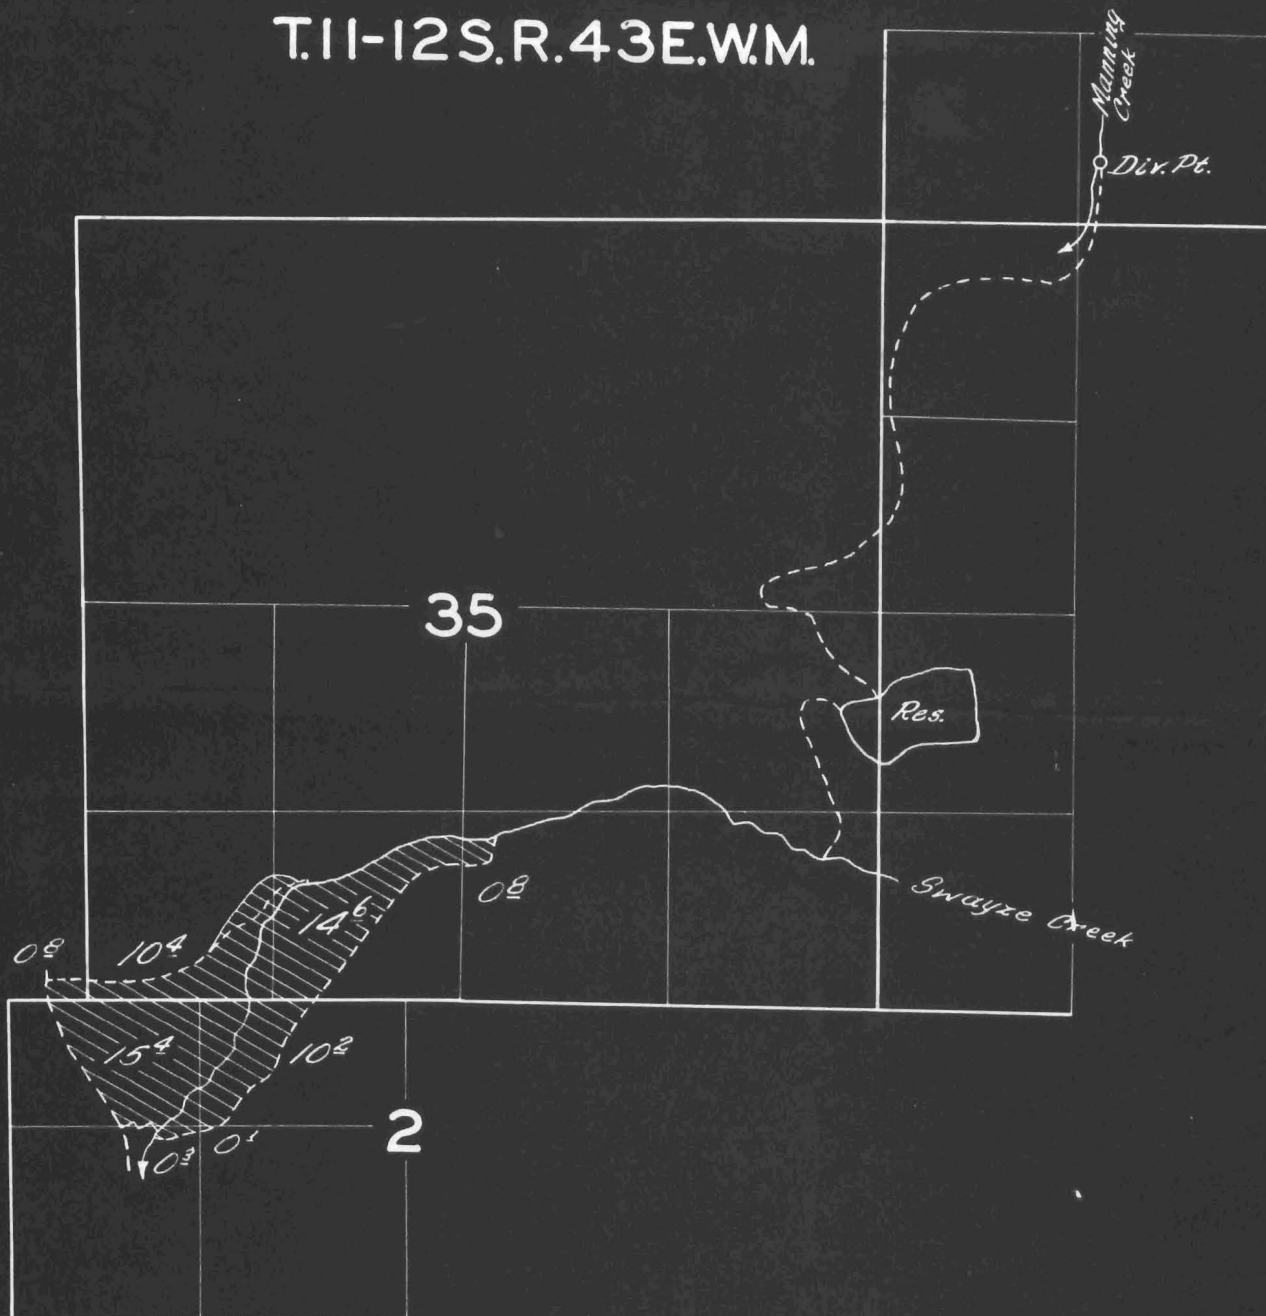


FINAL PROOF SURVEY
UNDER

Application No. *R-24328*
24094 Permit No. *R-1035*
19443
IN NAME OF

MOUNT MOORE

Surveyed *Nov. 10, 1956*, by *M. Bist*

T.11-12S.R.43E.WM.

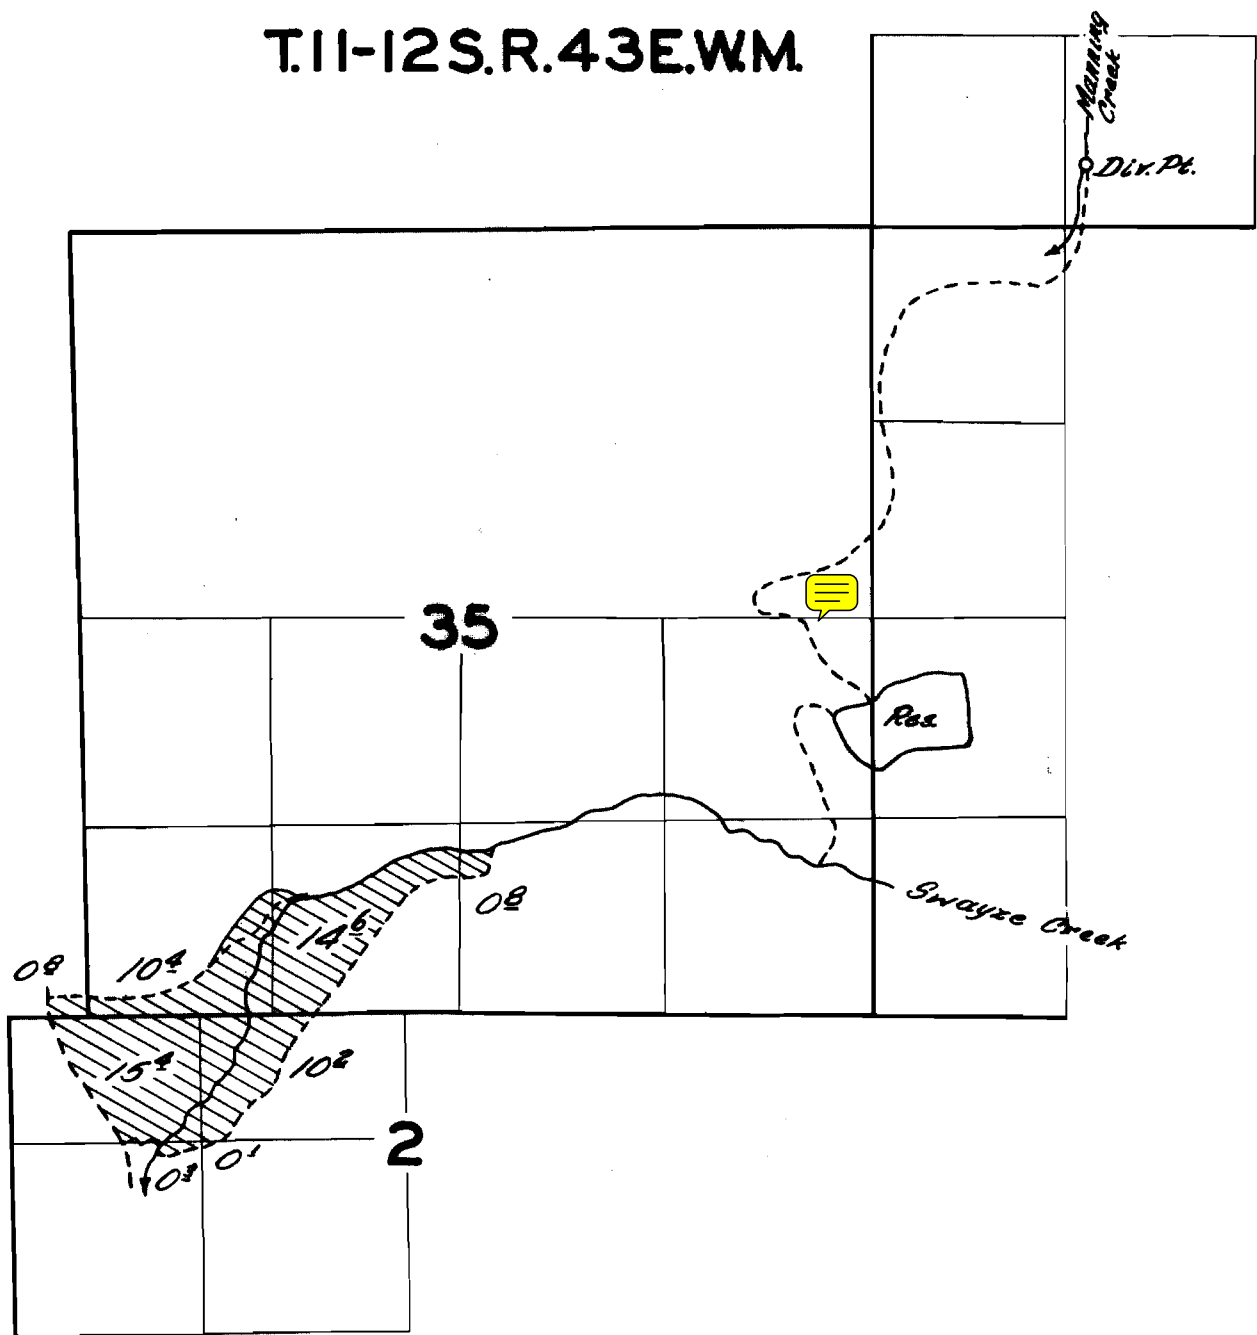

FINAL PROOF SURVEY
UNDER

Application No. ^{R-24328}~~24094~~ Permit No. ^{R-1035}~~19443~~
IN NAME OF

MOUNT MOORE

Surveyed Nov. 10, 1956, by M. Bist