


T.11-12S.R.43E.WM.

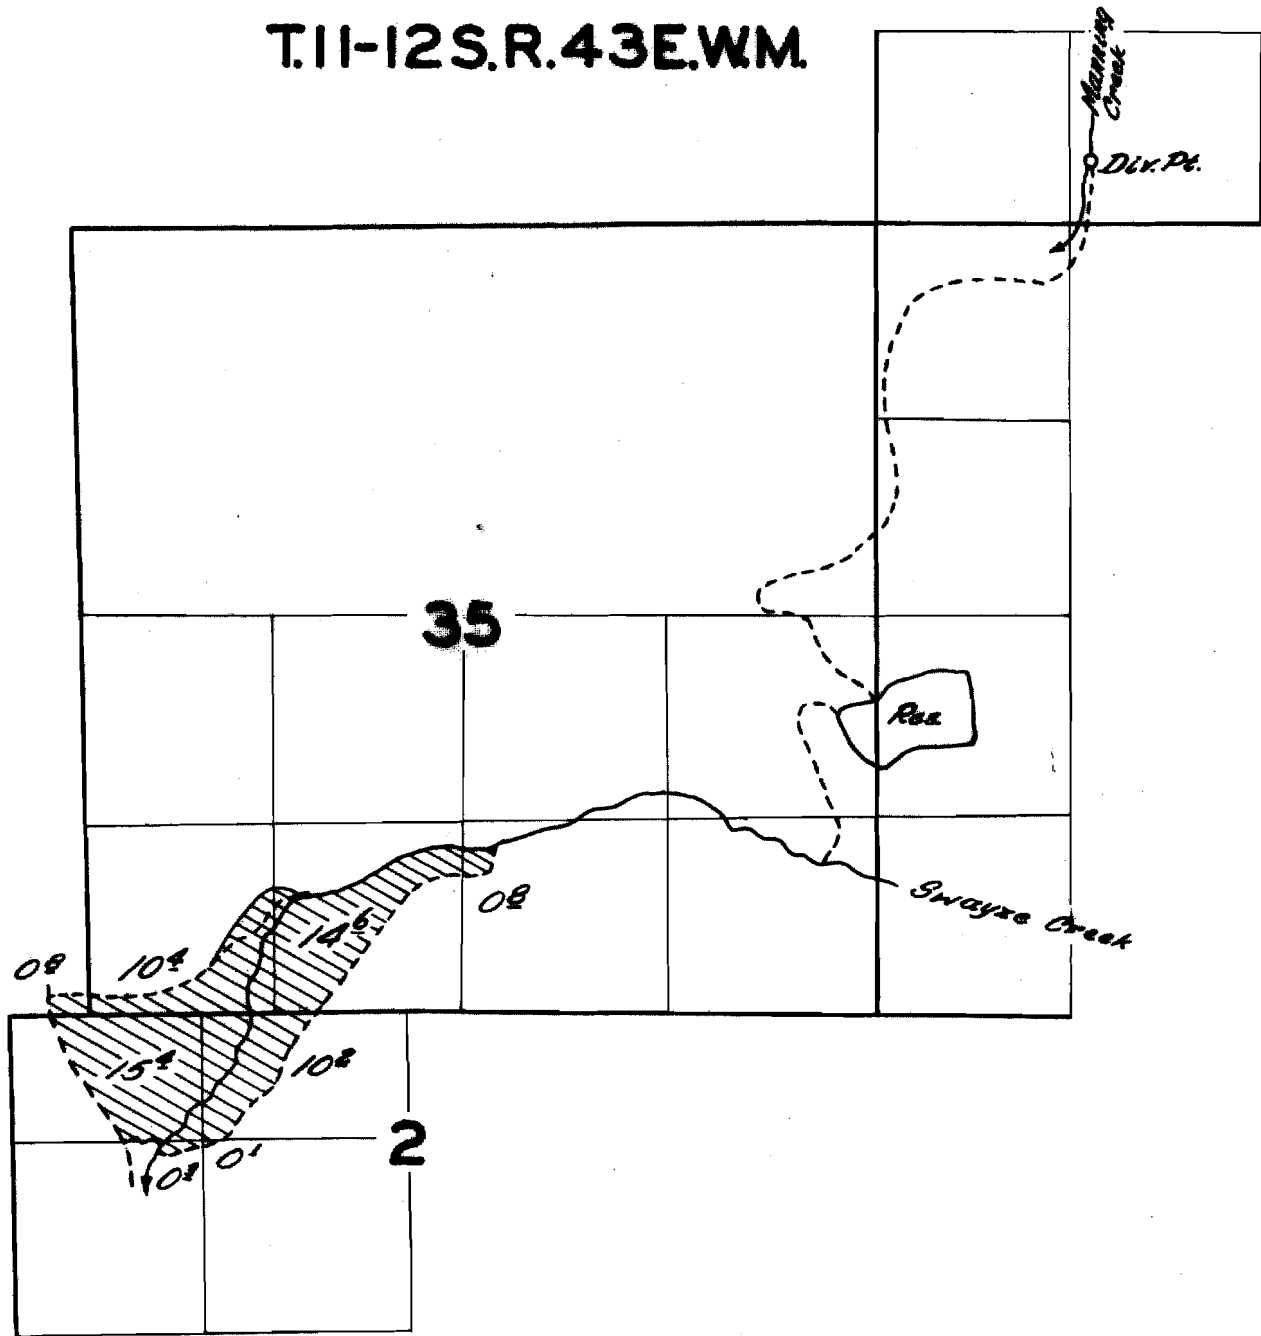


FINAL PROOF SURVEY
UNDER

Application No. ~~2409~~^{R-24328} Permit No. ~~19443~~^{R-1035}
IN NAME OF

MOUNT MOORE

Surveyed Nov. 10, 1956, by M. Bick

T.11-12S.R.43E.WM.

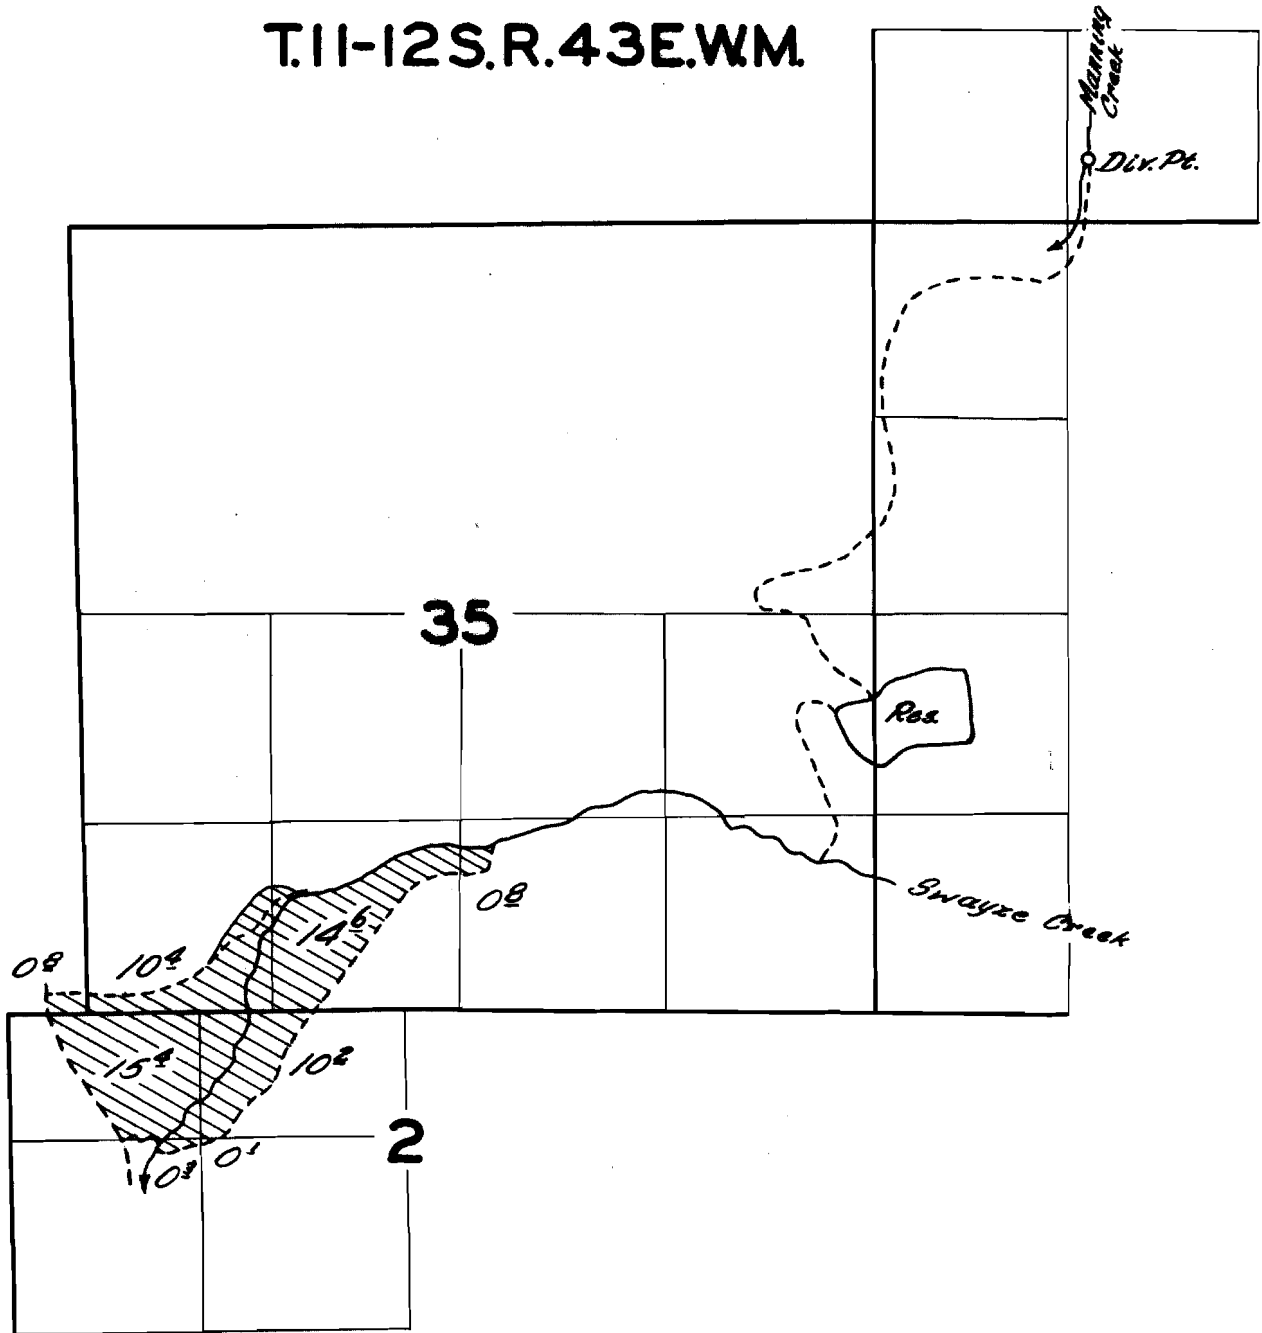

FINAL PROOF SURVEY
UNDER

Application No. ^{R-24328} ~~24028~~ Permit No. ^{R-1035} ~~19443~~
IN NAME OF

MOUNT MOORE

Surveyed Nov. 10, 1956, by M. Bisk