


T.4 S.R.17 E.W.M.

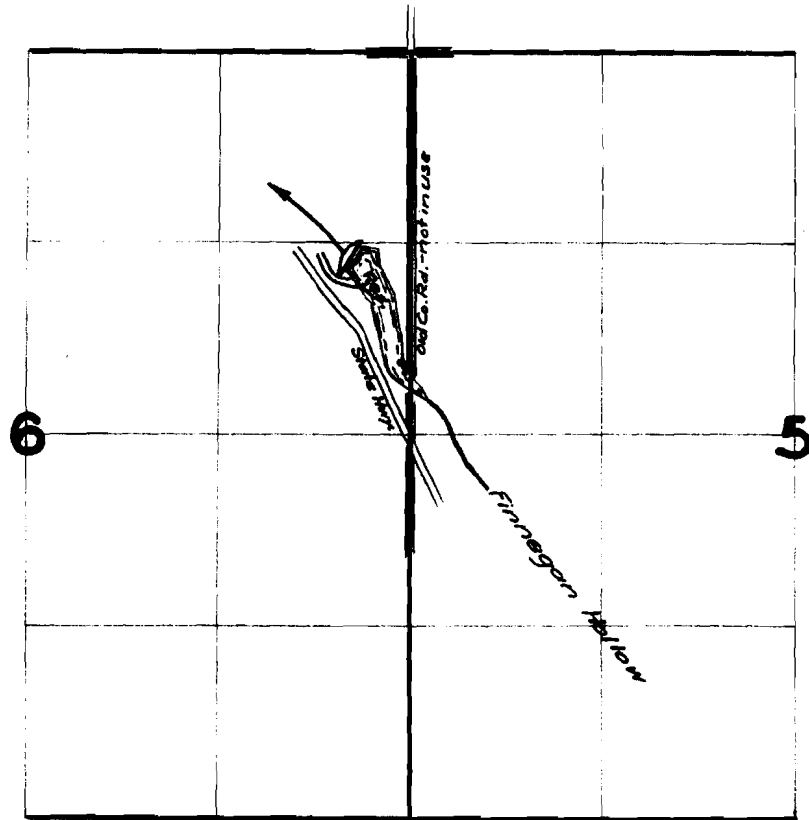

FINAL PROOF SURVEY UNDER

Application No. ²⁹⁶⁴¹~~R-29528~~ Permit No. ²³²⁵²~~R-1684~~
IN NAME OF

THEODORE VON BORSTEL

Surveyed 27 Oct. 1957, by M. Bick