


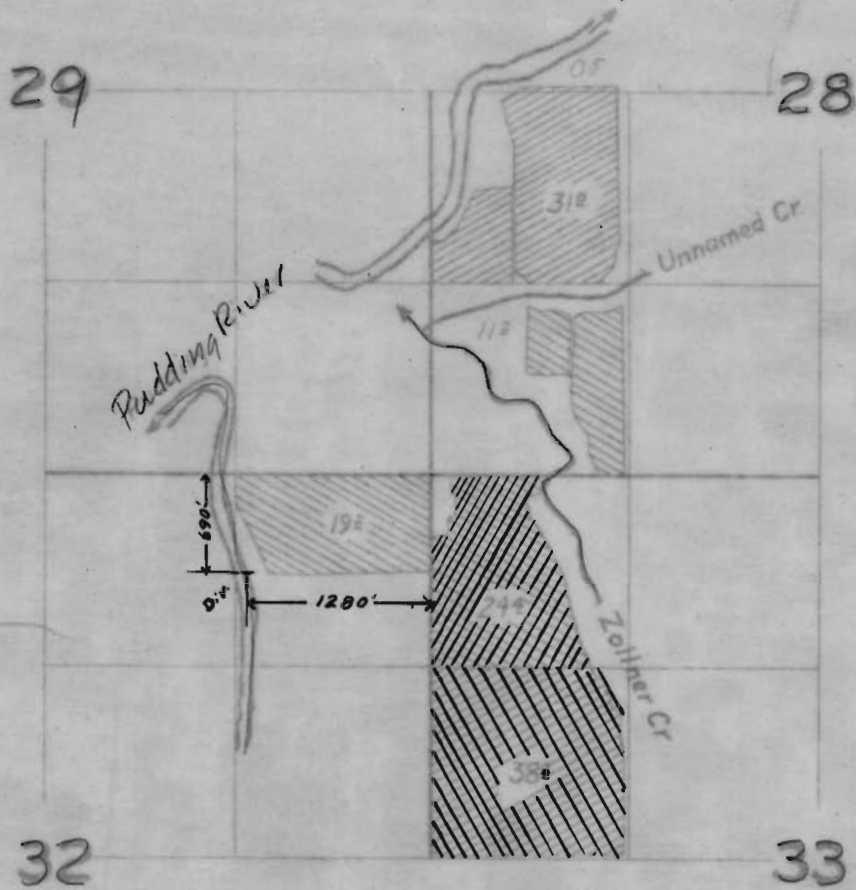


T.5S.R.1W.WM



Appl. No. 25021 
Appl. No. 20402 
Appl. No. 29884 
29804

FINAL PROOF SURVEY
UNDER

 Application No. Permit No.
NAME OF

L. J. Oberstinner

Application No. 29804
Permit No. 23511