


# T.5S. R.3W. W.M.

YAMHILL COUNTY

GRAND

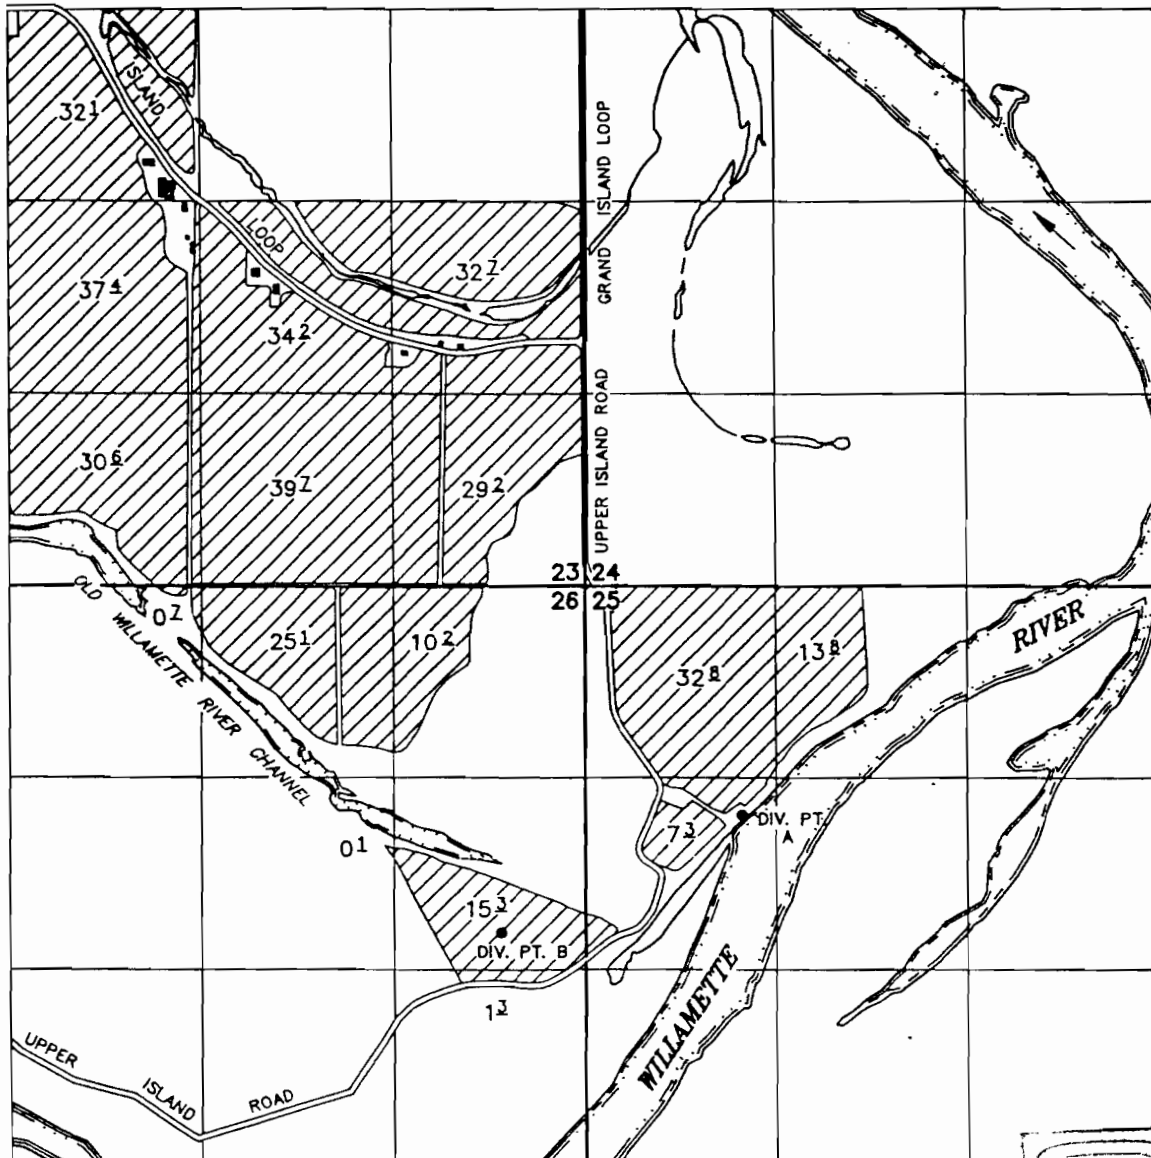

DIV. PT. A: 1585' S AND 1050' E FROM THE NW COR SEC 25  
 DIV. PT. B: 2383' S AND 585' W FROM THE NE COR SEC 26

## FINAL PROOF SURVEY

UNDER

**TAX LOTS:**

053W23 00600  
 053W23 01100  
 053W23 01200  
 053W23 01300  
 053W25 00100  
 053W26 00100  
 053W26 00200  
 053W26 00800

GR-1540	GR-1483
GR-1541	GR-1484
GR-1542	GR-1485
GR-3155	GR-2961
GR-3156	GR-2962
GR-3276	GR-3276
GR-3568	GR-3277
G-1476	G-1354
17944	13625
17950	13631
30616	24121
	31301
	13772
	13774

Application No. S-72039 Permit No. 52060 Certificate No. \_\_\_\_\_

### A & R SPADA FARMS

NOTE: This map is for the purpose of identifying the location of water rights and has no intent to dimension or locate property ownership lines.

SEPTEMBER 14, 1999

SCALE: 1" = 1320'

