


T. 36 S., R. 1 W., W. M.

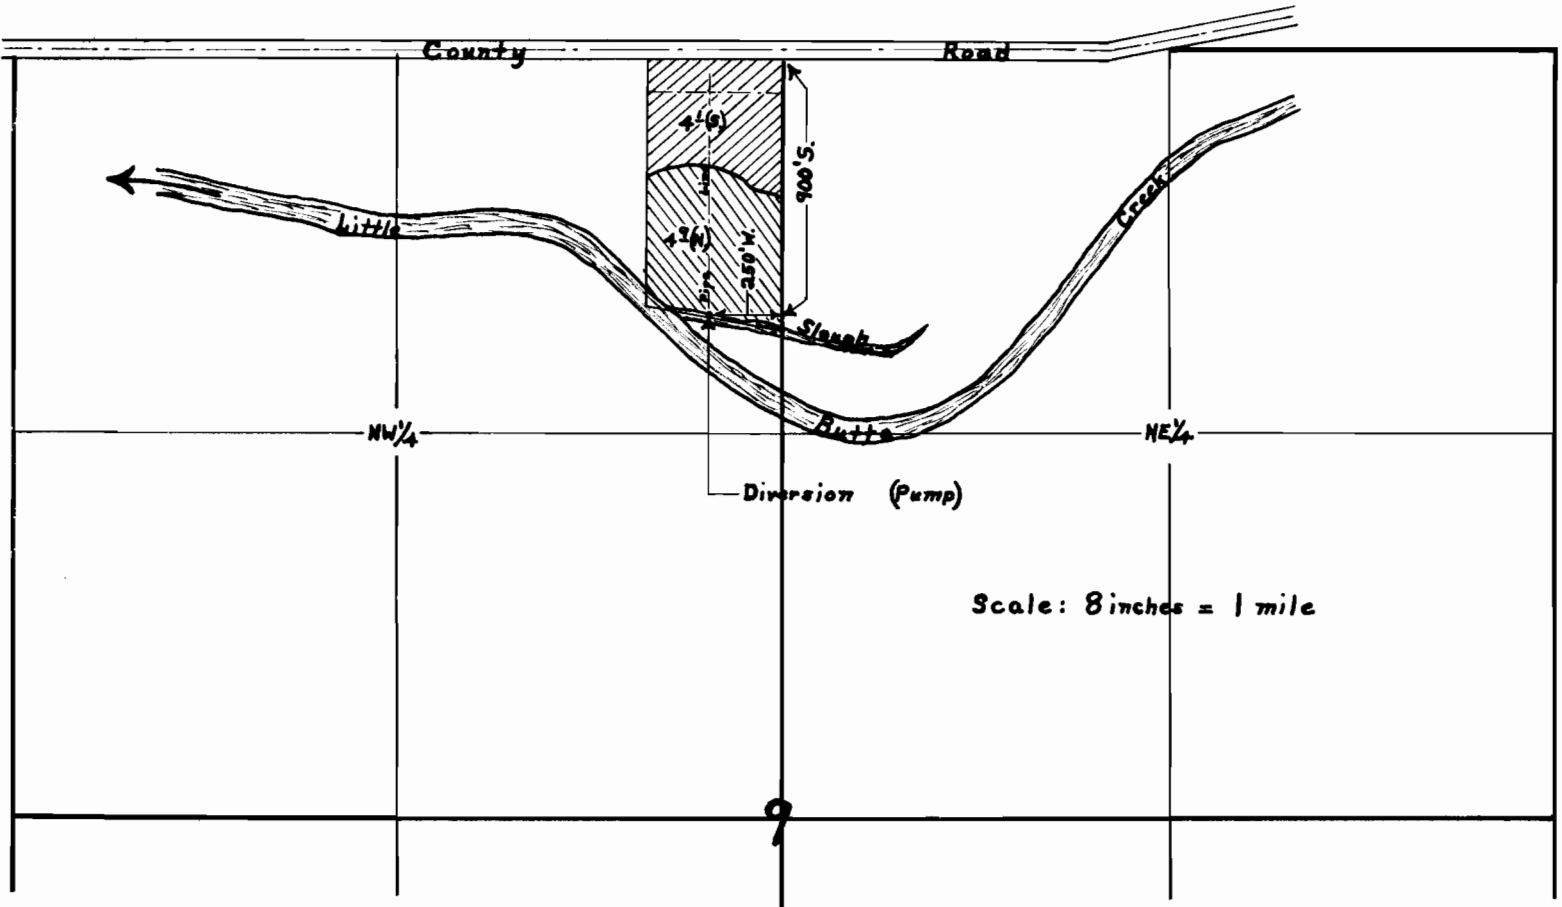

Map to accompany application of William W. Jackson, for use of water from a Slough for Irrigation and Supplemental Irrigation purposes.

This Office - March 24, 1956

David C. Hendrix, Watermaster

RECEIVED
MAR 27 1956
STATE ENGINEER
SALEM, OREGON

Application No. 30626
Permit No. 24130