


55 gal. barrel cut in half
lengthwise and welded end to end
20 ft. 2" pipe
SPRING
LP. 4611N. & 3460E
of SW Cor. Sec. 19
T. 36 S., R. 14 W., W.M.
wood & earth
dam 4x1 ft.

(B)

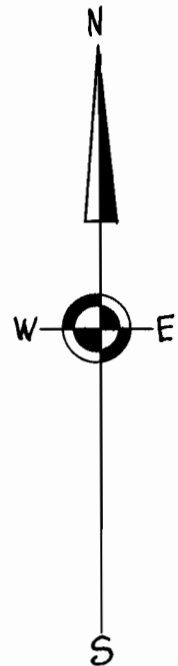

lengthwise
55 gal. barrel cut in half & welded end to end
20 ft. 2" pipe
earth & wood dam 4x1 ft.
SPRING
IP 1531 N & 11 W of SE Cor. Sec. 24
T. 36 S., R. 15 W., W.M.

(A)

T. 36 S., R. 15 W., W.M.
T. 36 S., R. 14 W., W.M.



MAP FOR
KATE BAILEY WATER FILING
SHOWING PART OF
SEC. 24, T. 36 S., R. 15 W. & SEC. 19, T. 36 S., R. 14 W., W.M.
CURRY CO., ORE.

Scale 1 in. = 500 ft.

Feb. 1957

24 19 IP Found
25 30

31412
Permit No. 24758
30