


T.3S.R.3E.W.M

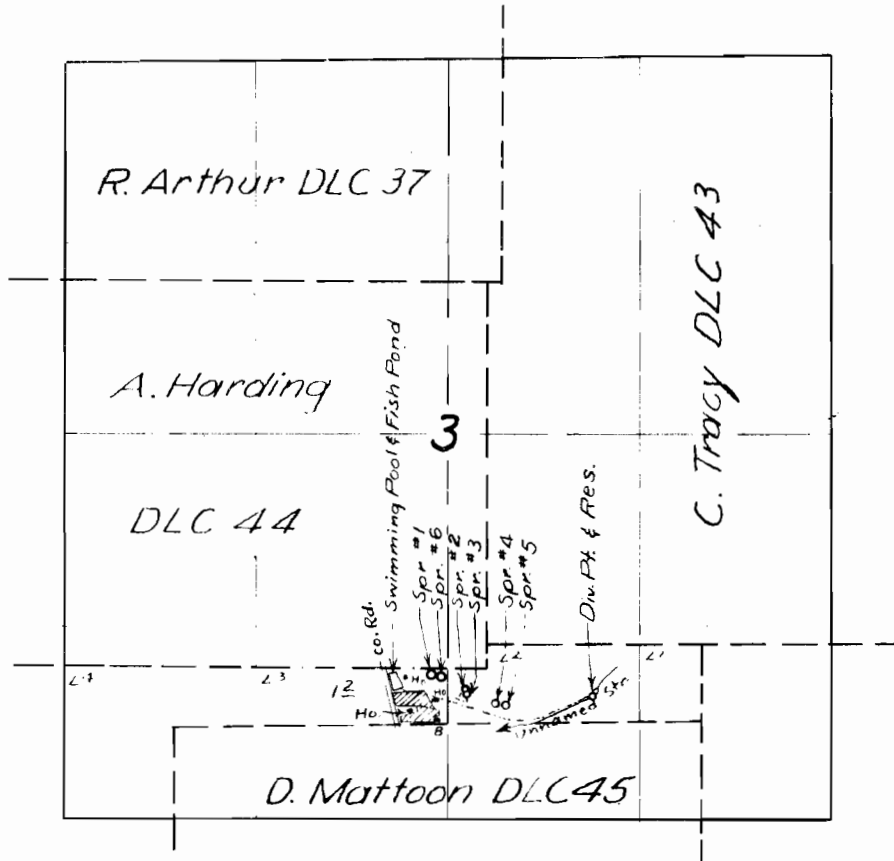

UNDER
R-24768 R-1057
Application No. 24769 Permit No. 19666
IN NAME OF

Estate of Alfred P. Waer

Surveyed 30 Aug 1956, by *M. Bush*

Application No. 31456
Permit No. 24804

1956 K