


SECTION 34

TOWNSHIP 2 S. RANGE 5 E. W. M.

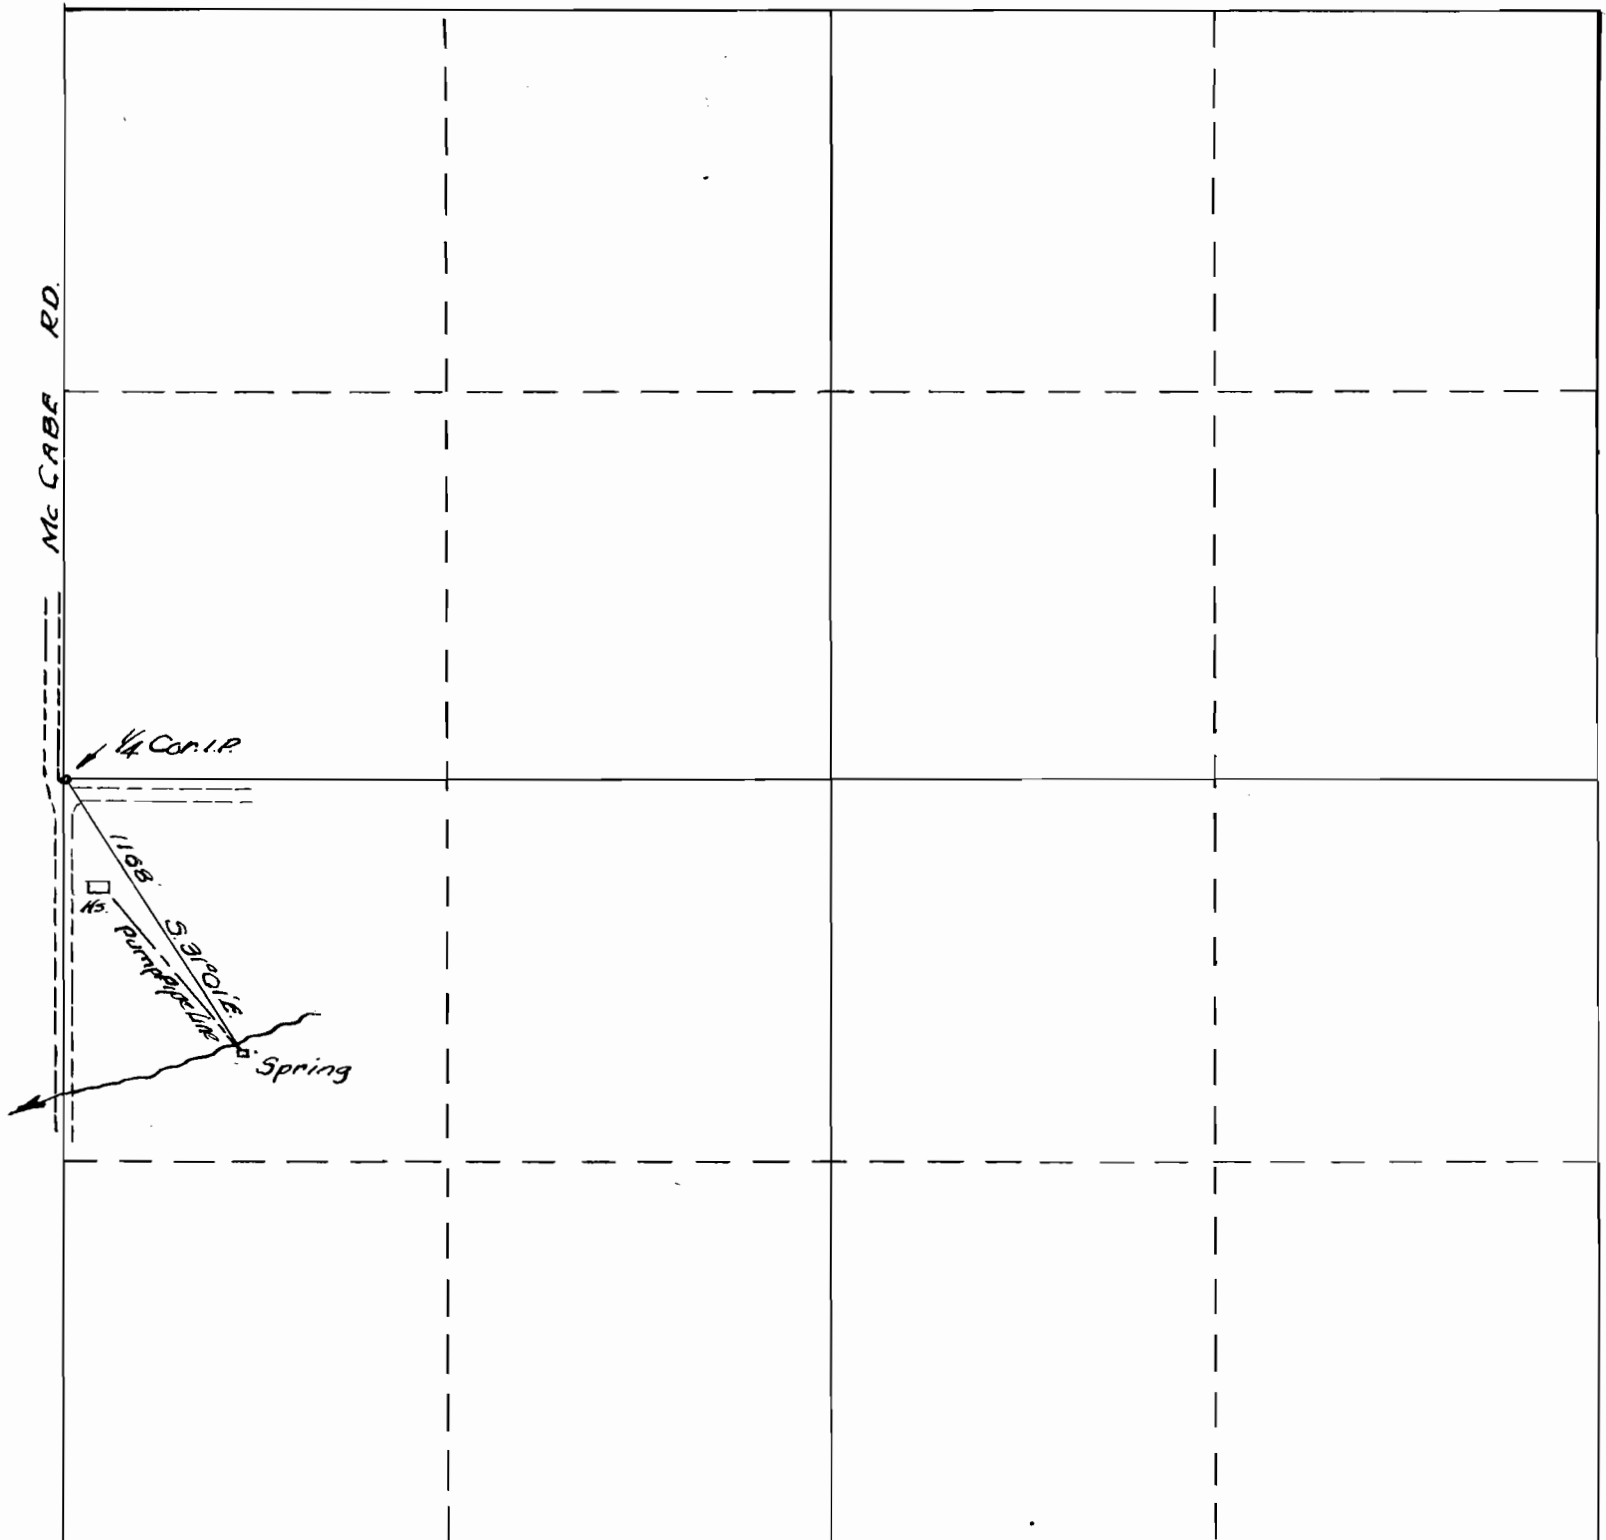

Application No. 31718

Permit No. 25167

For domestic use only.

Spring runs 59 p.m.

3/4" plastic pipe from Spring to house.

1/2 h.p. Sears Homart piston type pump.

Spring emptys into Bear Creek tributary.

Concrete Cylindrical Reservoir 24" x 48"

