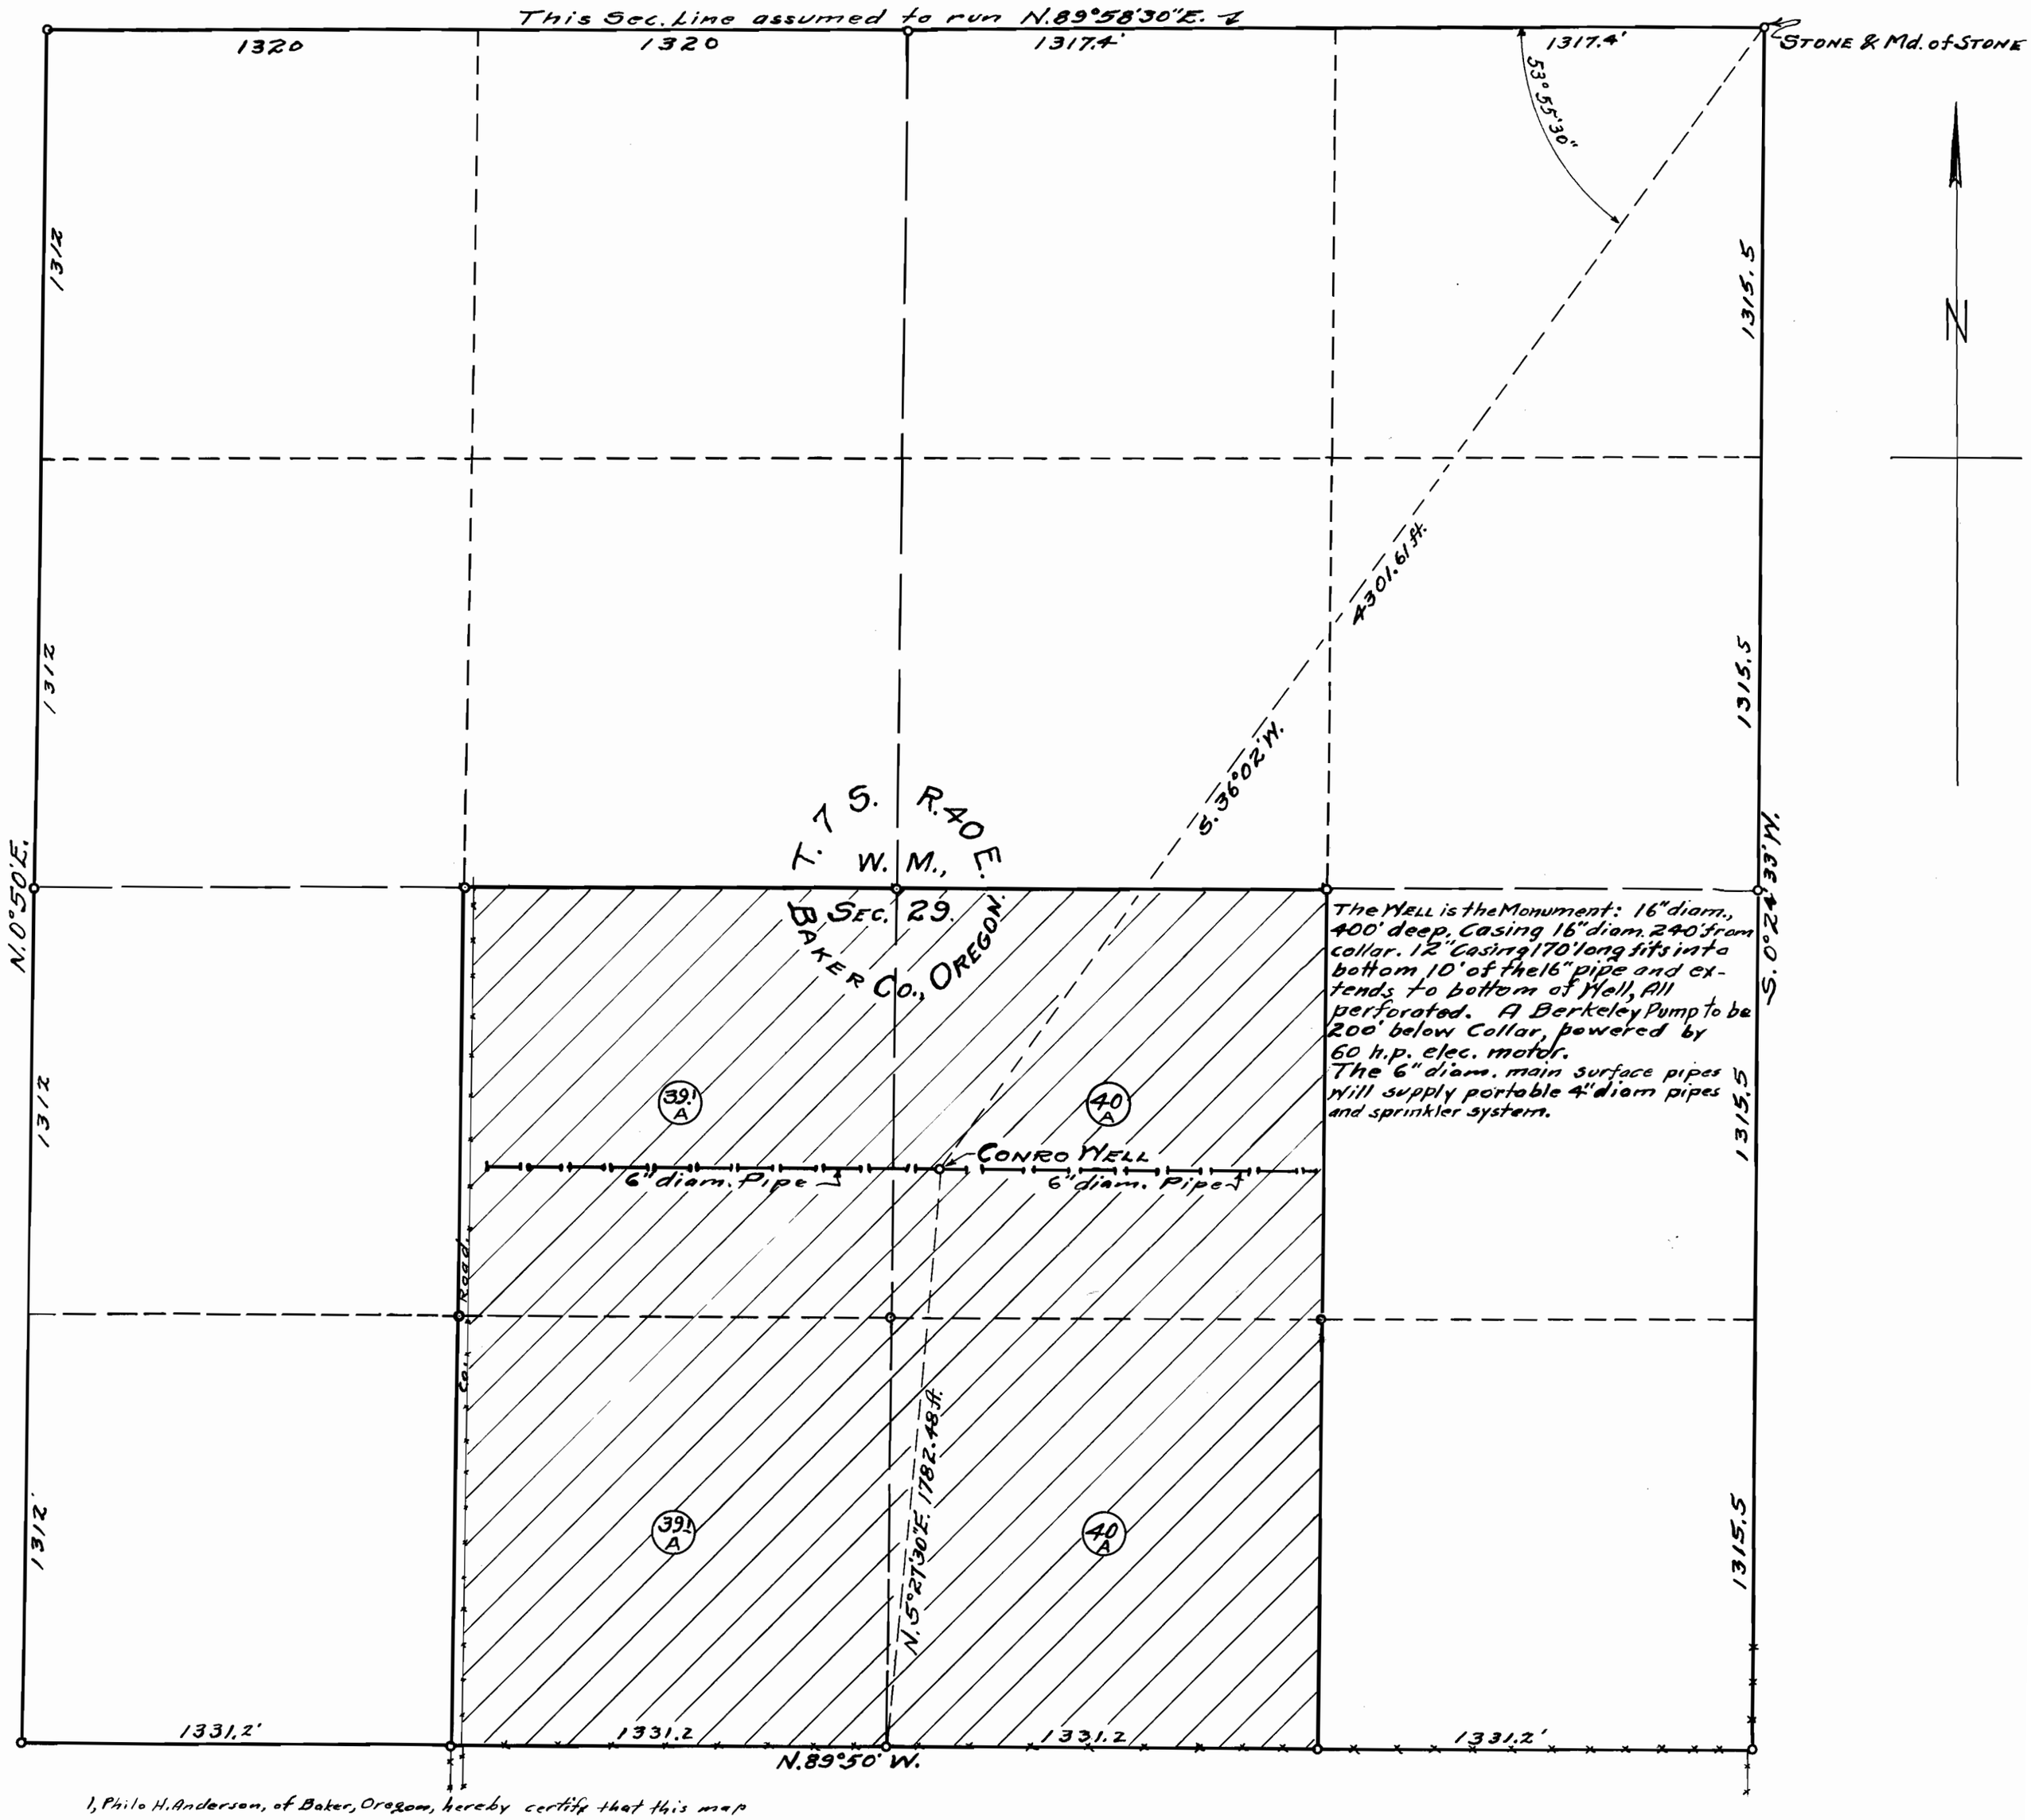

I, Philo H. Anderson, of Baker, Oregon, hereby certify that this map was made from notes taken during an actual survey made by me April 20, 1954, and that the Monument shown on this map, consisting of an Iron Pipe Well Casing, 16" in diameter about 18" above ground, bears N. 5°27'30" E., 1782.48 ft. from the 1/4 Sec. corner between Secs. 29 and 32, T. 7 S., R. 40 E., W.M., in Baker County, Oregon.

Philo H. Anderson

Map to Accompany Application for Permit to Appropriate Underground Water for Irrigation Purposes,

Floyd Conro, of Haines, Oregon, Applicant.

Scale: 1" = 400'. R.F. 1/4800.

Application No. U-788
Permit No. U-