


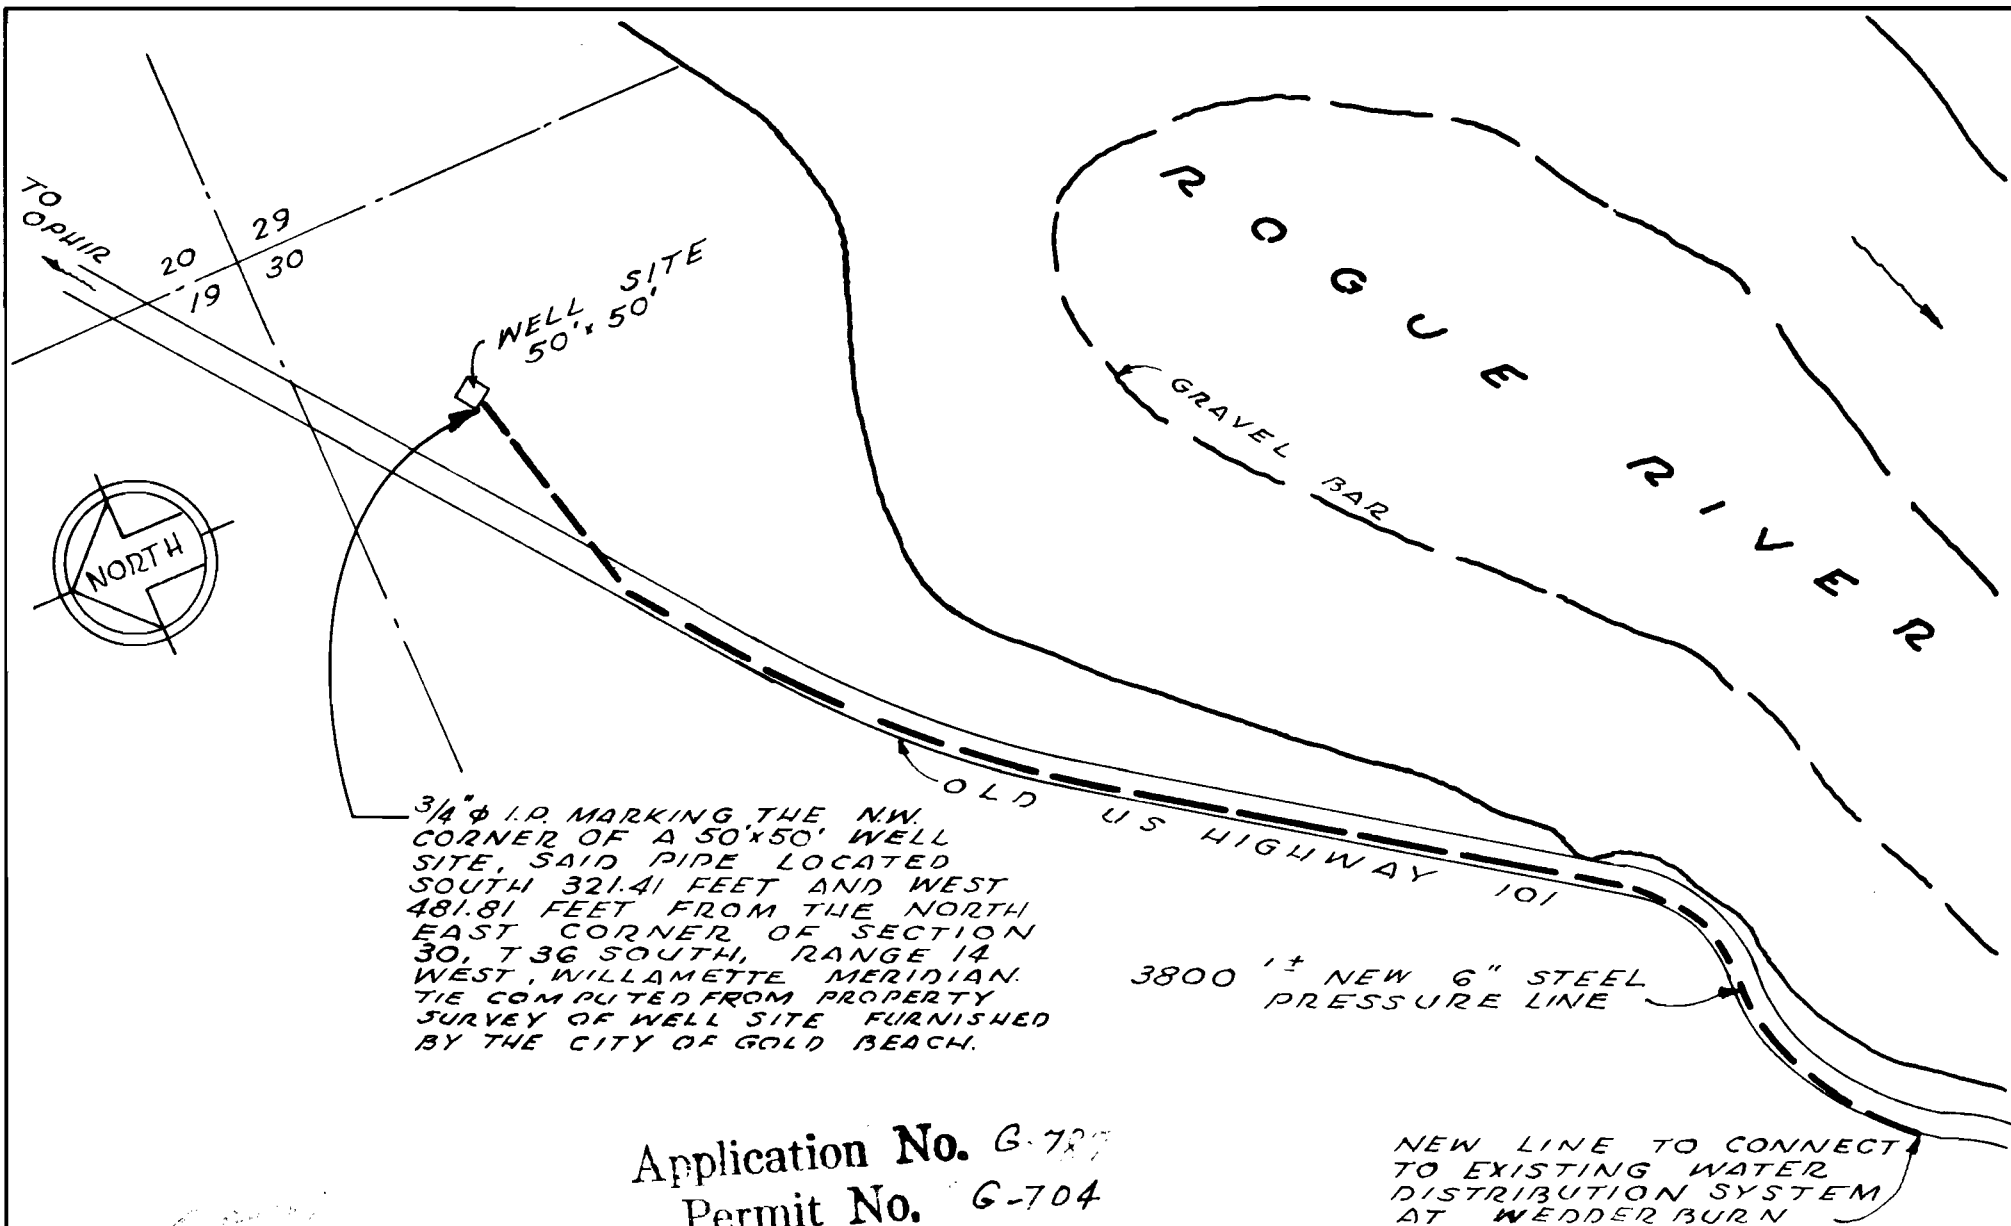

Edward W. Riley
REGISTERED CIVIL ENGINEER
2682
OREGON
MAY 9 1967
EDWARD W. RILEY

WATER RIGHTS SURVEY
FOR GROUND WATER PERMIT
NE 1/4, NE 1/4, SECTION 30, T.36 SOUTH
RANGE 14 WWM. CURRY COUNTY,
OREGON
FOR THE CITY OF GOLD BEACH
SCALE 1" = 400'
10, OCTOBER 1957
R.H. ERICSEN CONSULTING ENGINEER
E.W. RILEY
COOS BAY.