


T. 1N. R. 13-14E. W.M.

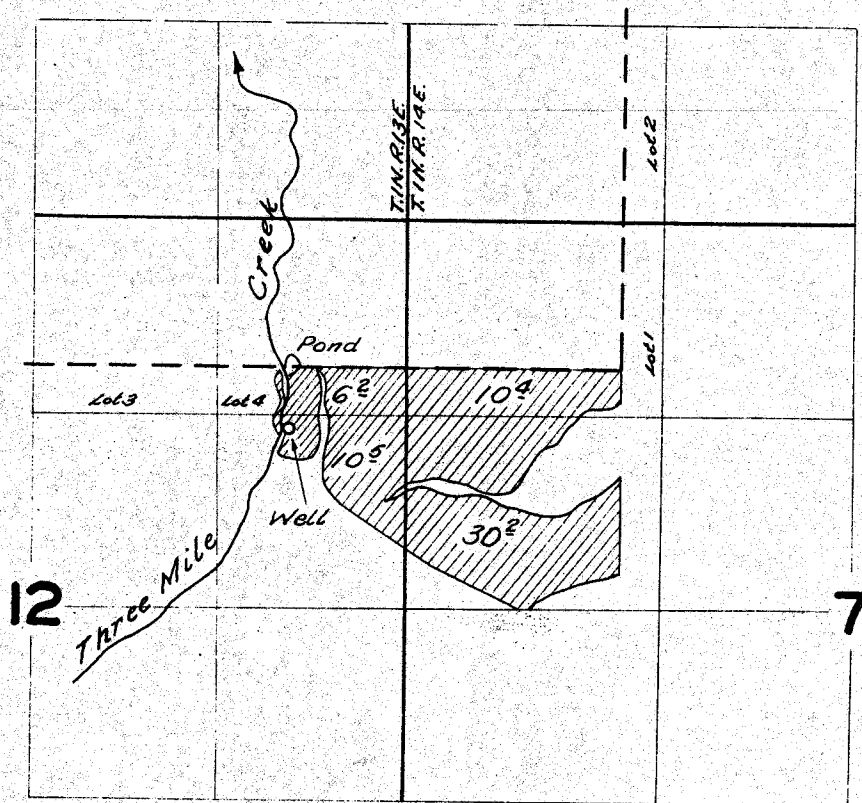

FINAL PROOF SURVEY UNDER

Application No. *U-168* Permit No. *U-162*
IN NAME OF

John McClaskey

Surveyed *June 11, 1954*, by *H.L. Coffman*