


T.34S. R.6E.W.M.

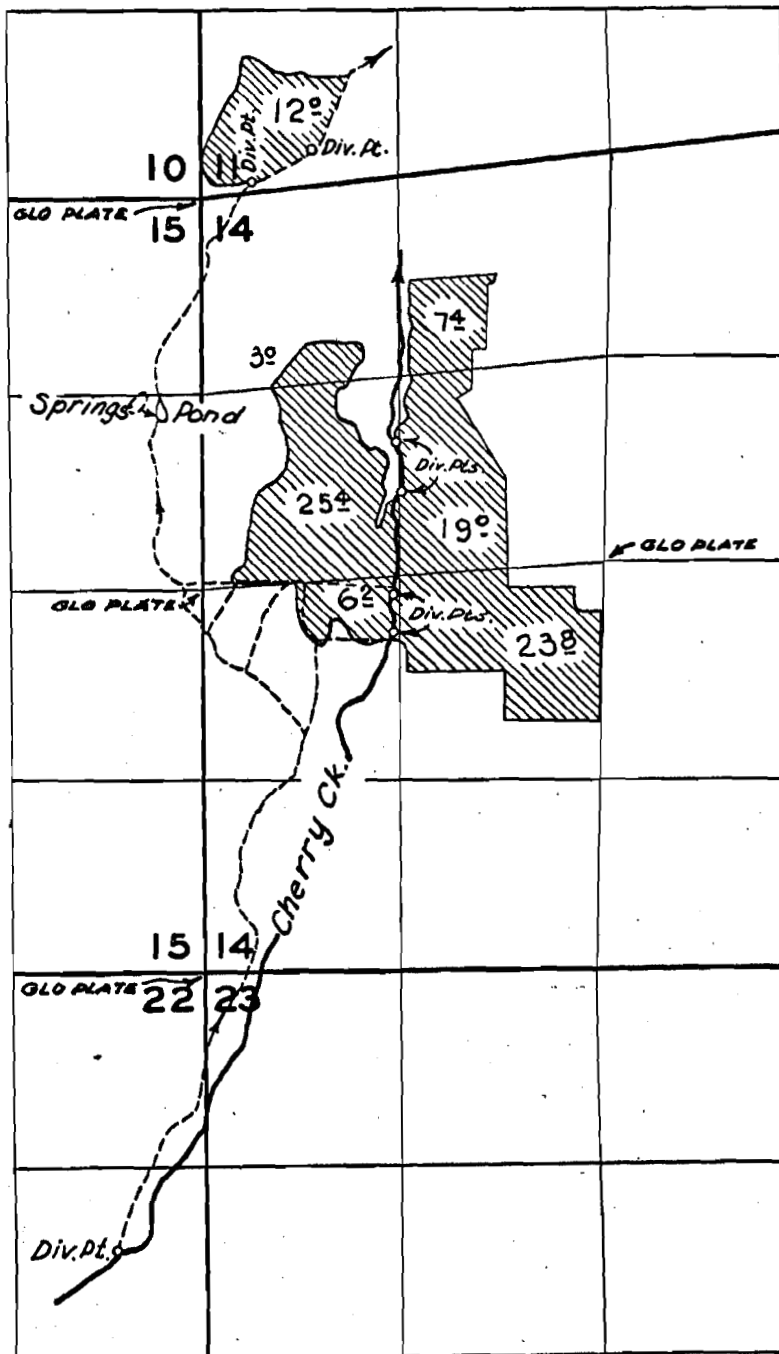

FINAL PROOF SURVEY UNDER

Application No. 14661... Permit No. 11280...
IN NAME OF

FRED G. & CECIL M. BROWN

Surveyed 3 May 1958, by C.O. Bartels..

Cherry Ck. & Pond