


T.6 S. R.4 W.W.M.

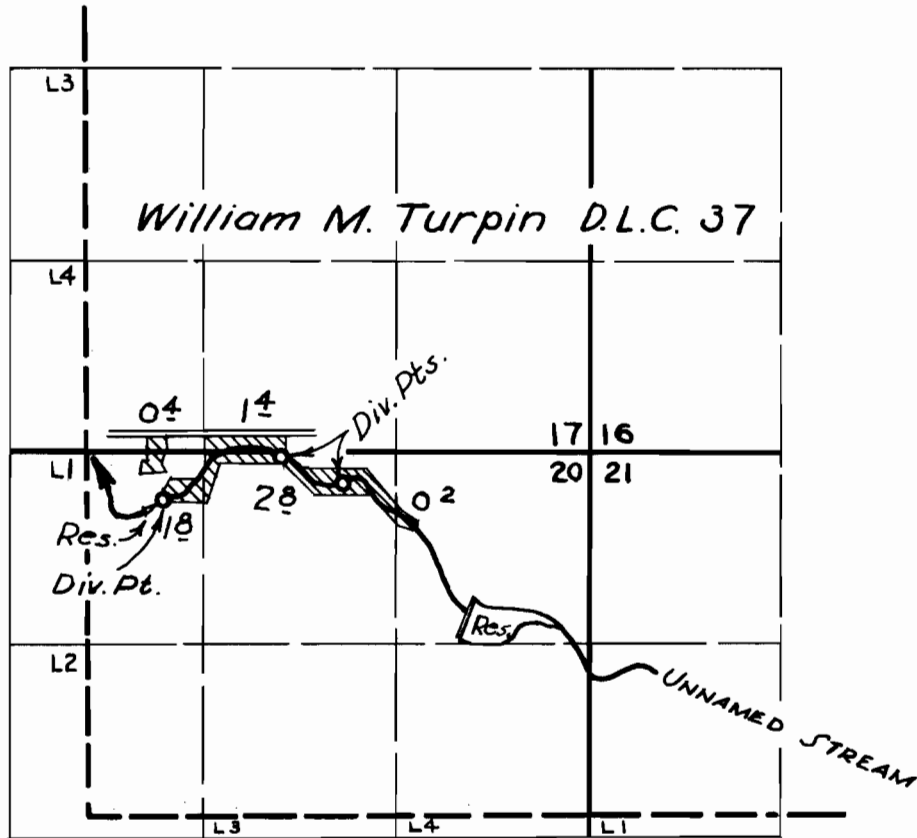

FINAL PROOF SURVEY
UNDER

R-24255 R-1087
Application No. 24256 Permit No. 19916
IN NAME OF

DOMES TURKEY FARM

Surveyed Mar. 26 1957, by R.H. Whitby