


T.5S. R.3E.W.M.

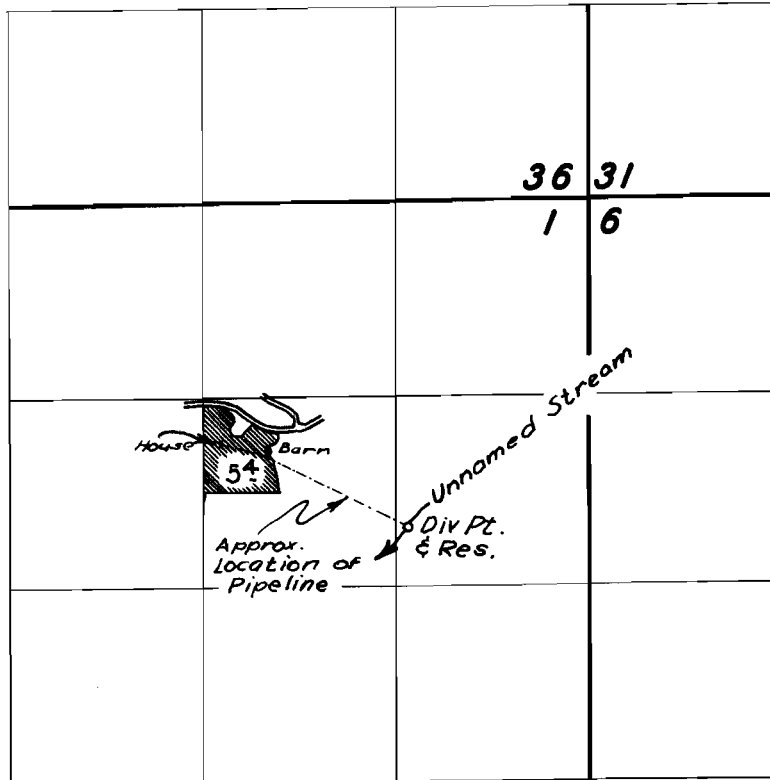

**FINAL PROOF SURVEY**  
UNDER

R-26731 R-1355  
Application No. 26732 Permit No. 21258  
IN NAME OF

**CARL V. SHORE**

Surveyed 18 June 1958, by C.O. Bartels