


T. 5S. R. 3E. W.M.

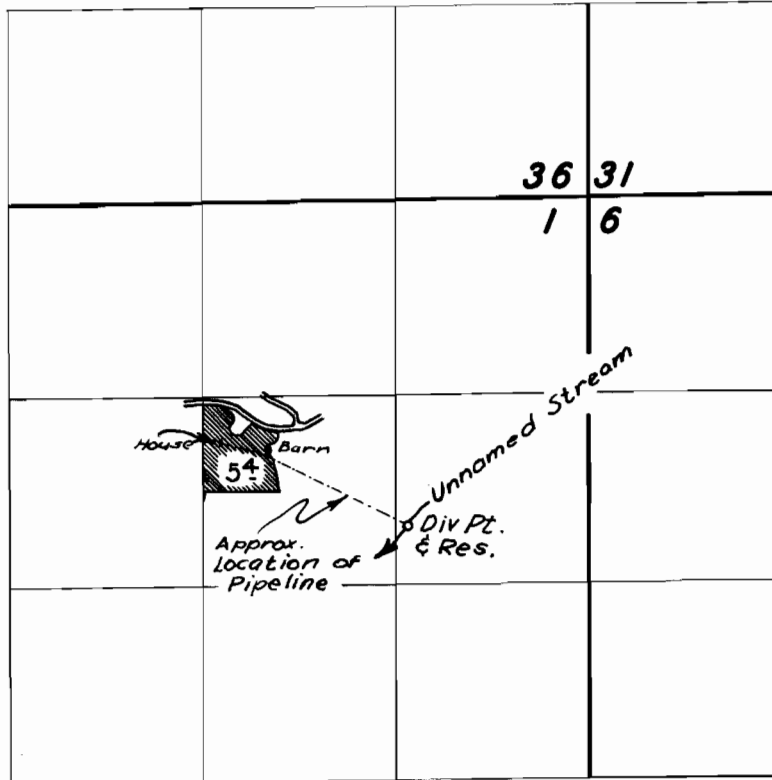

FINAL PROOF SURVEY
UNDER

R-26731 R-1355
Application No. 26732 Permit No. 21258
IN NAME OF

CARL V. SHORE

Surveyed 18 June 1958, by C.O. Bartels