
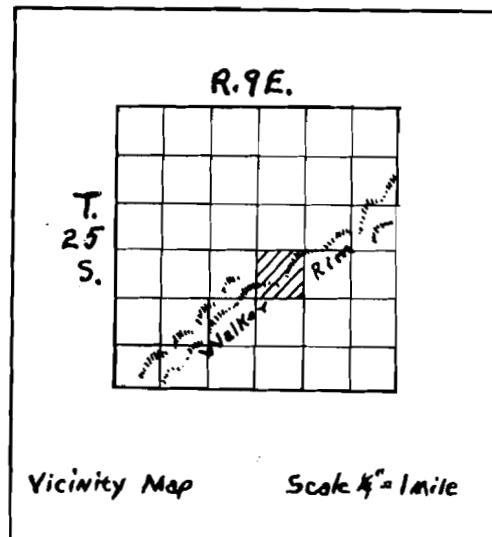


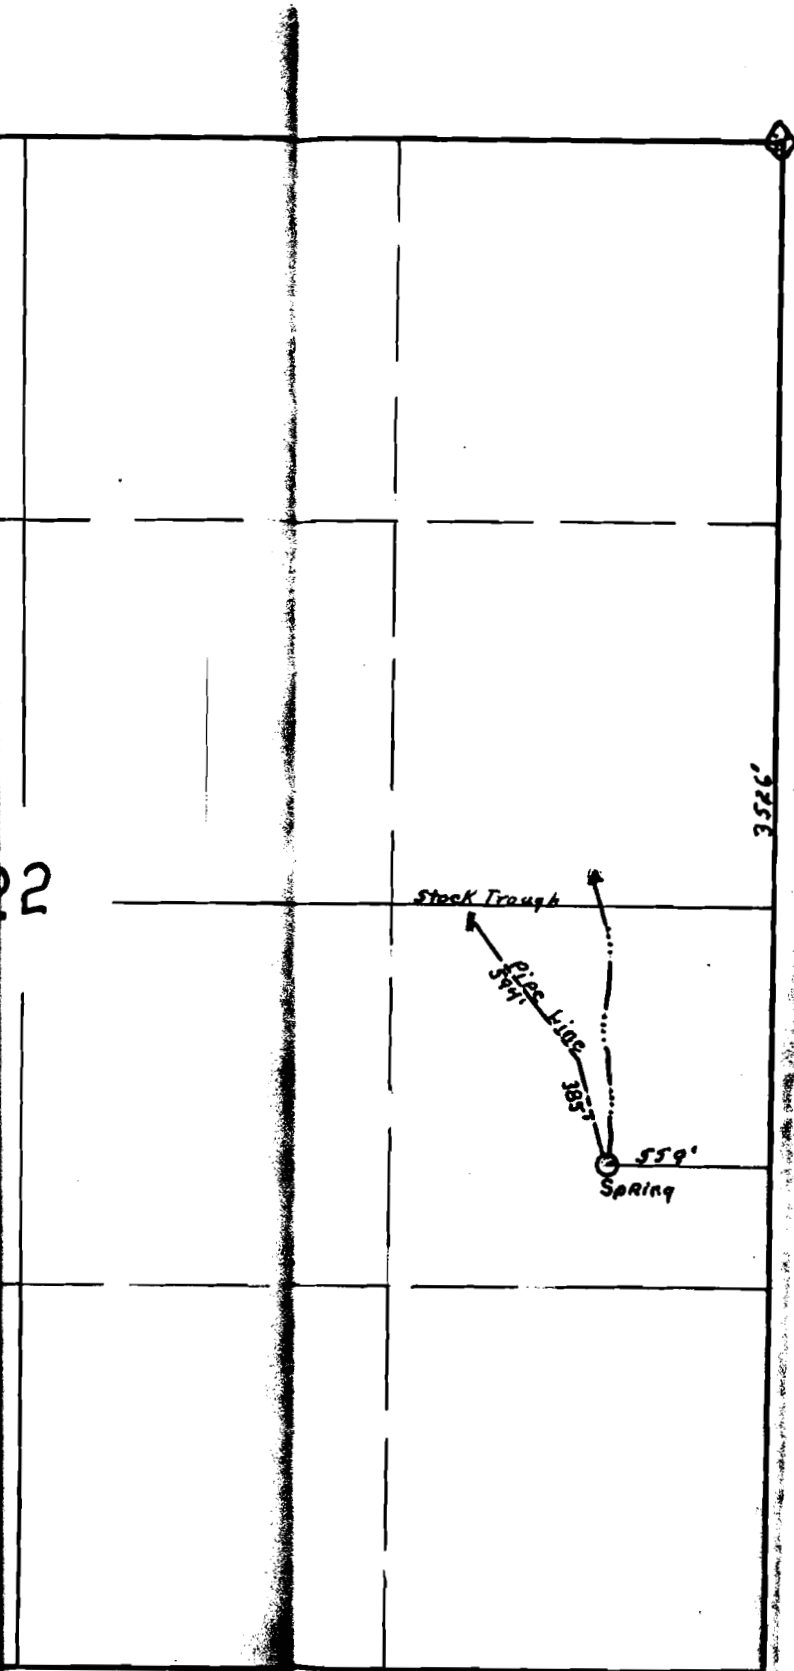

18719 OK
5-20

Appl. No. 18719
Per. No. 14338

RECEIVED

MAY 15 1940
STATE ENGINEER
SALEM, OREGON