


T. 10S. R. 5E. W.M.

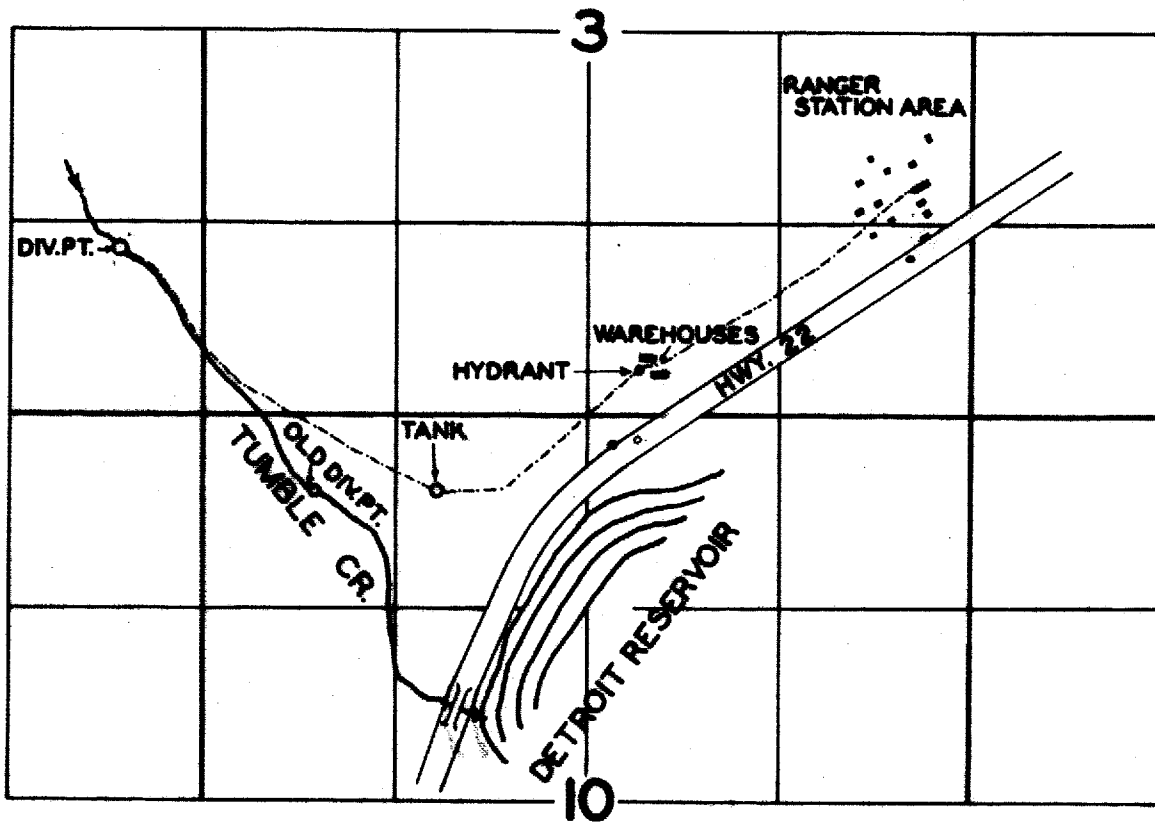

FINAL PROOF SURVEY
UNDER

Application No. 21684 Permit No. 17028
IN NAME OF

.....
Surveyed OCT. 11, 1957, by *m. Bish*