


# T.16 S.R.4 E.W.M.

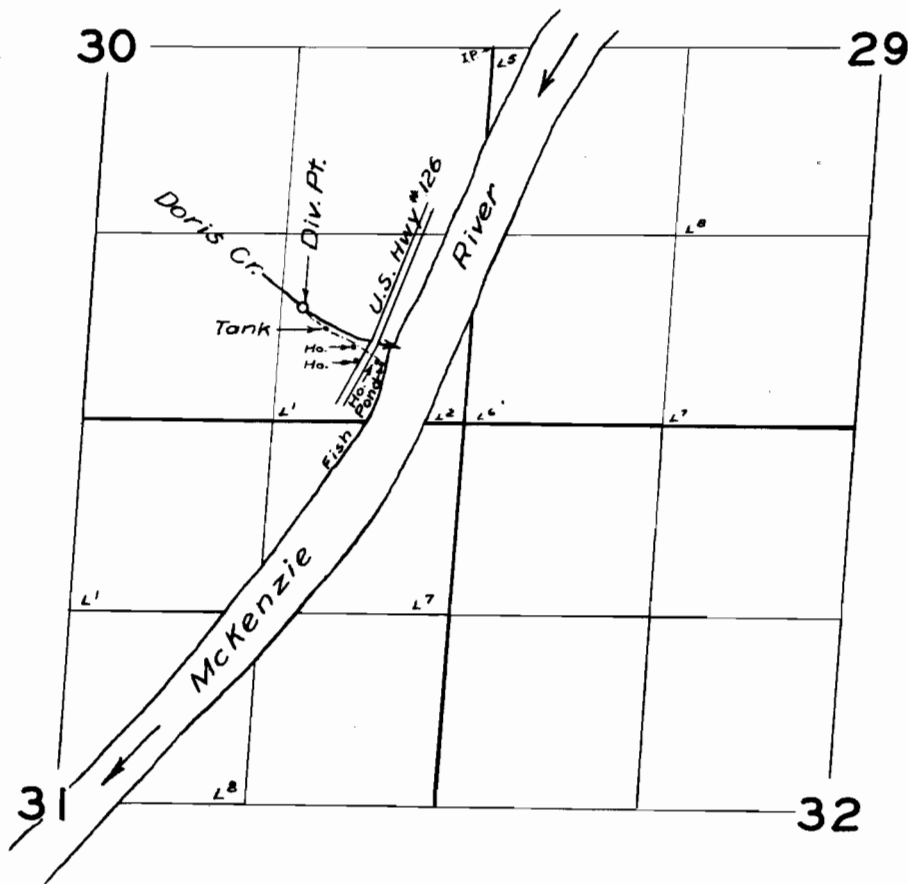

## FINAL PROOF SURVEY

UNDER

Application No. 22207 Permit No. 17488

IN NAME OF

David C. Brown

Surveyed June 28 1957, by Tom. Bish