


T.40S.R.14W.W.M.

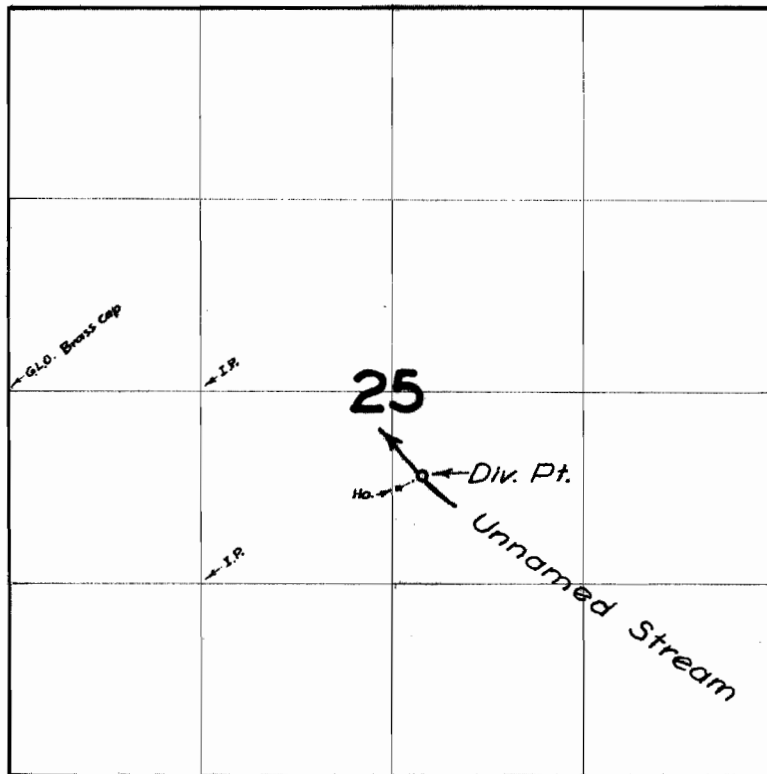

FINAL PROOF SURVEY
UNDER

Application No. 22458 Permit No. 17685
IN NAME OF

Olive M. Weise

Surveyed 25 Mar. 1958, by M. Bish