


T. 13 S. R. 26 E. W.M.

36

31

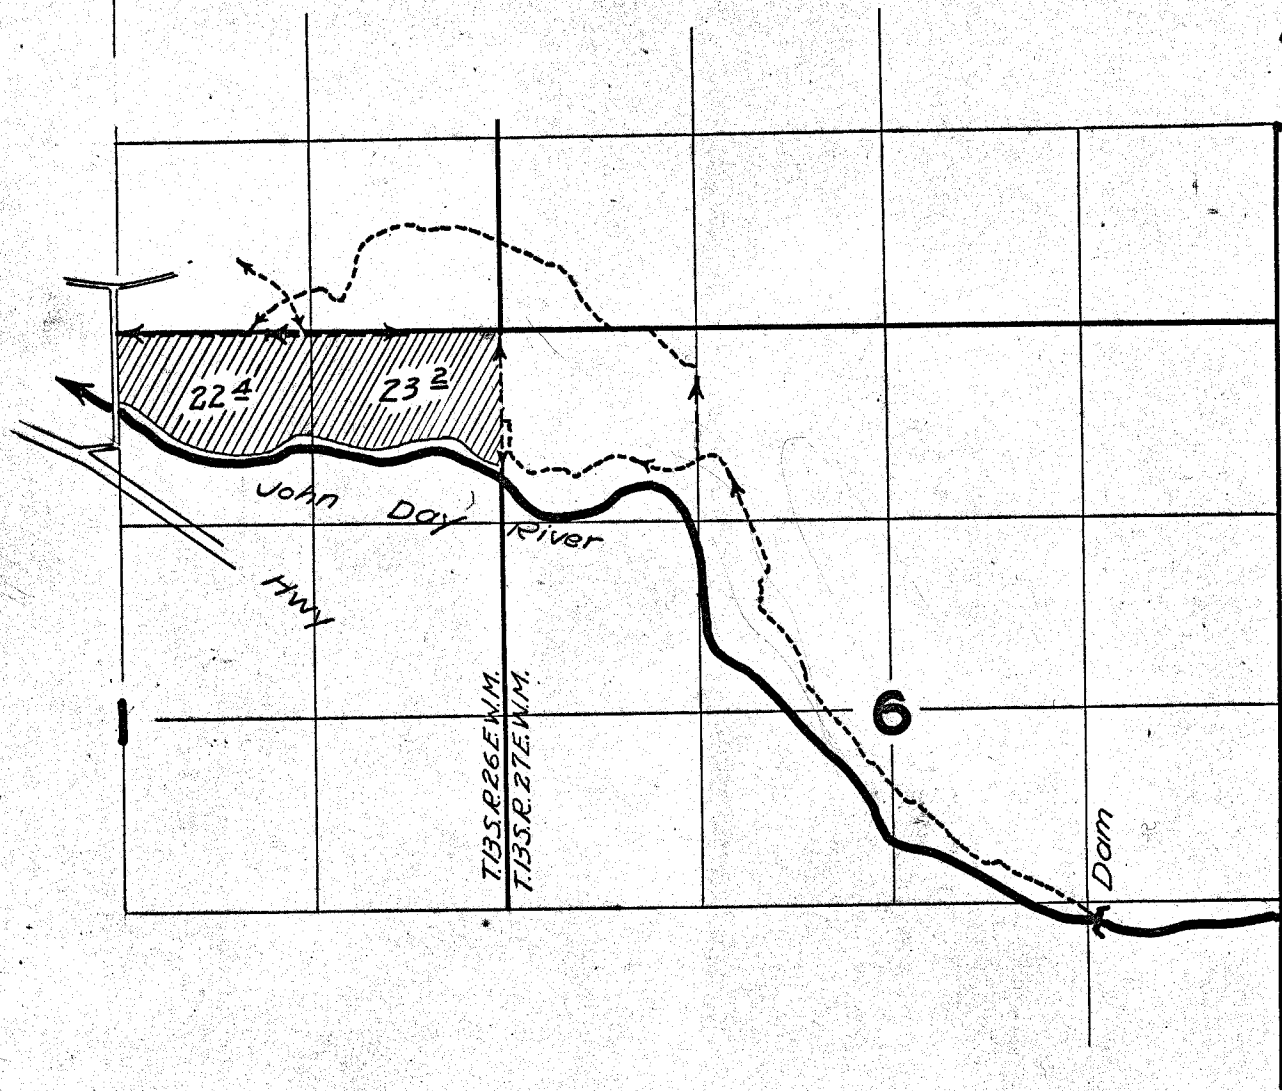

FINAL PROOF SURVEY

UNDER

Application No. 22007.... Permit No. 17969....

IN NAME OF

Duncan MacBain & Georgia MacBain.....

Surveyed Aug. 26 1954., by T. Jones.....

C4-7
Pantograph