
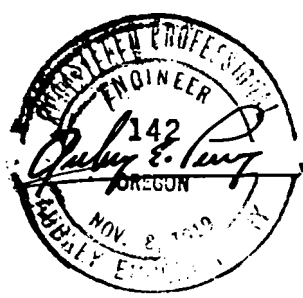


C-24619
57567

MAP TO ACCOMPANY APPLICATION OF C.W. BOGART
SISTERS - OREGON
SECTION 35 TOWNSHIP 14 SOUTH RANGE 10 EAST.
SCALE 8" = 1 MILE
T-4956

use as final proof map
as per RFM 1-2892
BMS

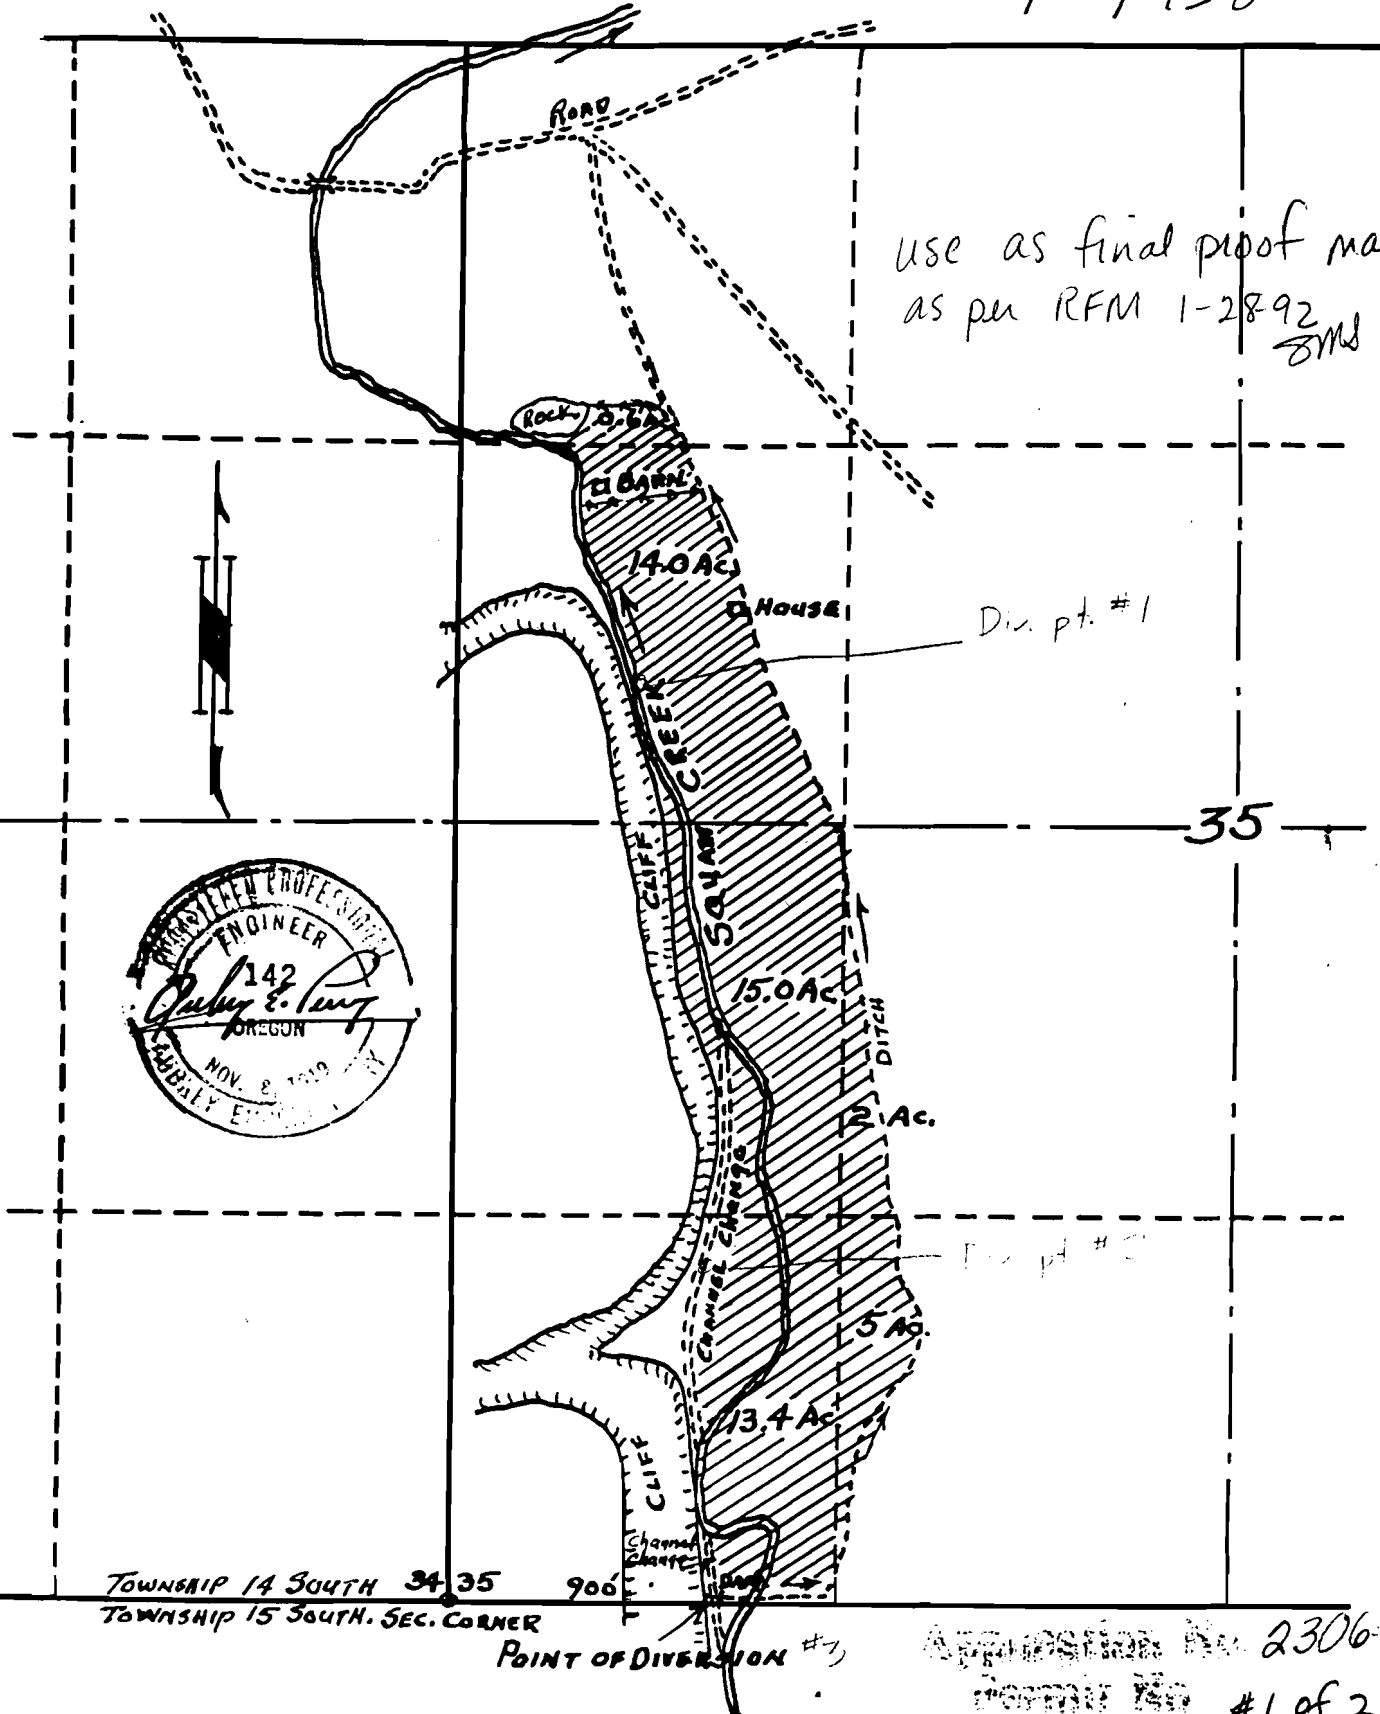

TOWNSHIP 14 SOUTH 34 35 900'
TOWNSHIP 15 SOUTH. SEC. CORNER

POINT OF DIVERSION #3

Application No. 23061
Form #1 of 2

18203