


T.41 S.R.13 W.W.M.

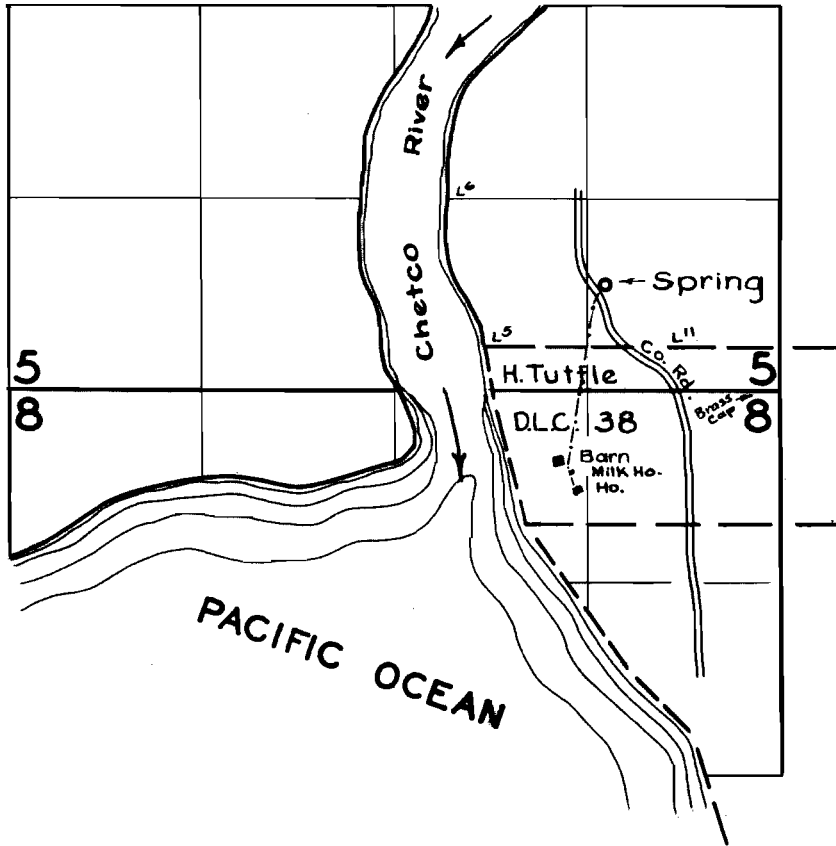

**FINAL PROOF SURVEY**  
UNDER

Application No. 24564 ..... Permit No. 19366 .....  
IN NAME OF

**B. A. McVay**

Surveyed Mar. 19, 1950, by *Tom Bush*