


T. 5S. R. 4W.W.M.

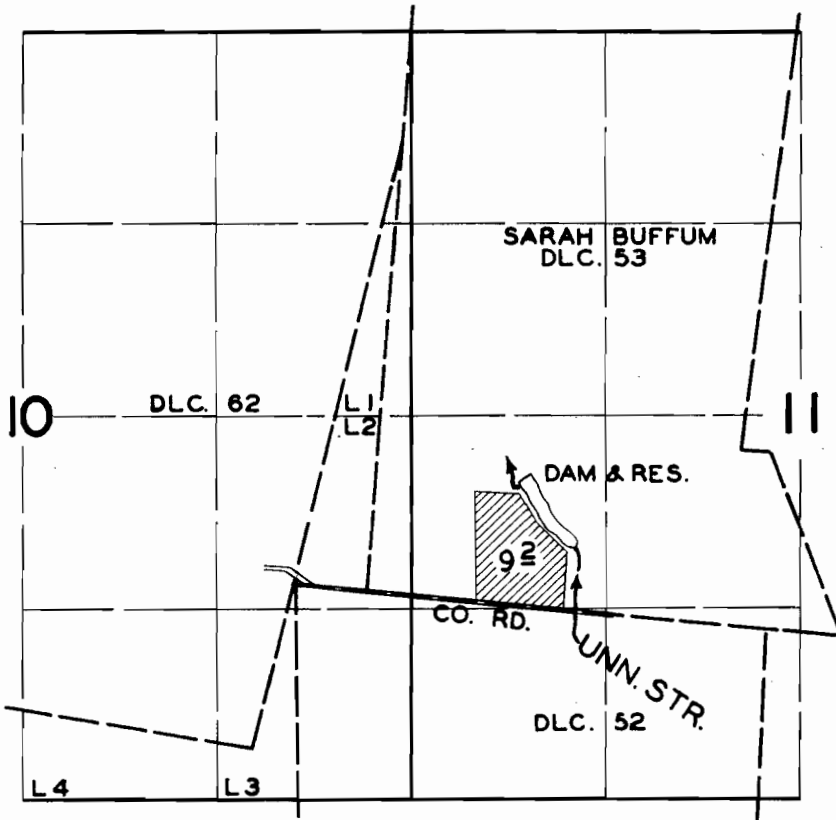

FINAL PROOF SURVEY
UNDER

R-27573 R-1415
Application No. 27574 Permit No. 21715
IN NAME OF

JESSE M. HOCKEMA

Surveyed JUNE 4, 1957, by *John H. Petty*