


T. 1 N. R. 2 W. W.M.

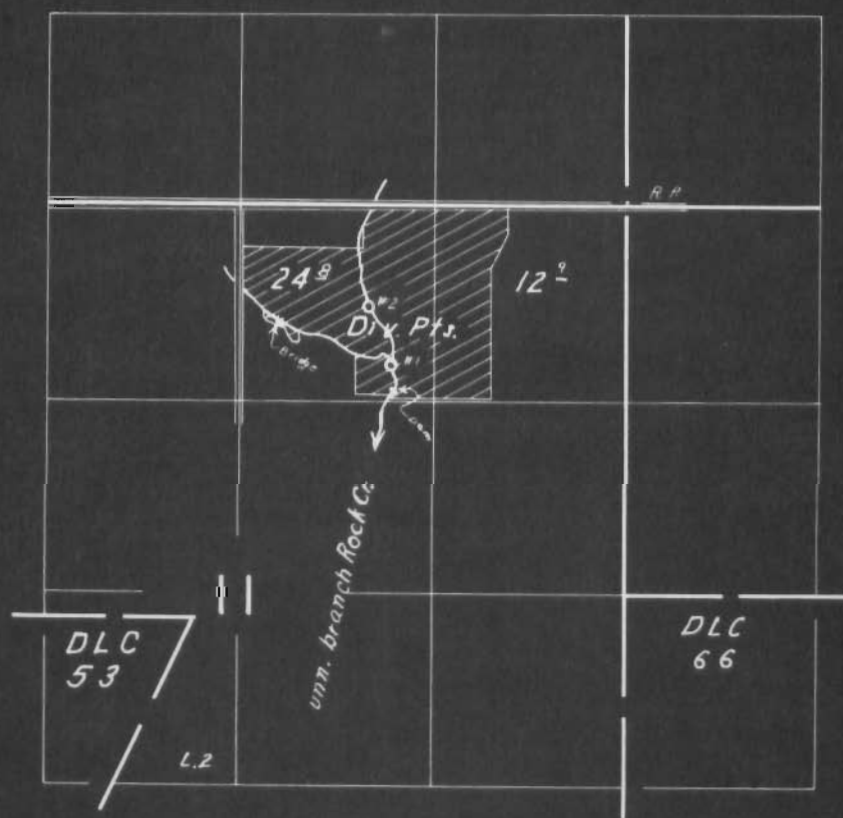


FINAL PROOF SURVEY
UNDER

R-29266 R-1637
Application No. 29267 Permit No. 23016
IN NAME OF

Carl & Matilda E. Dick

Surveyed *May 2* 1958, by *R.H. Whitby*

T. 1 N. R. 2 W. W.M.

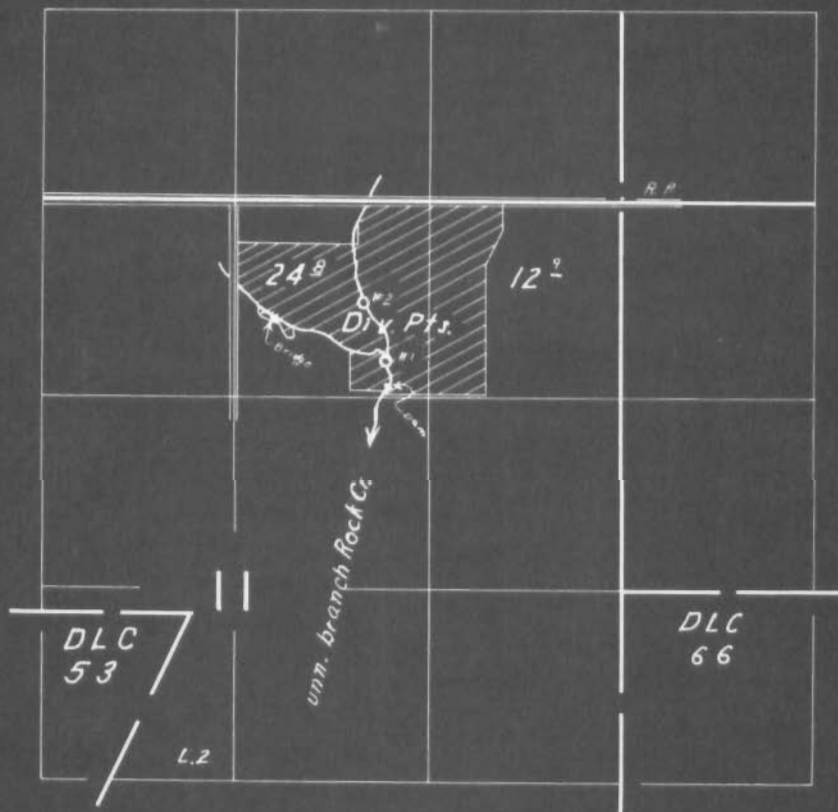

FINAL PROOF SURVEY
UNDER

R-29266 R-1637
Application No. 29267 Permit No. 23016
IN NAME OF

Carl & Matilda E. Dick

Surveyed *May 2* 1958, by *R.H. Whitby*