


T. 1 N. R. 2 W. W.M.

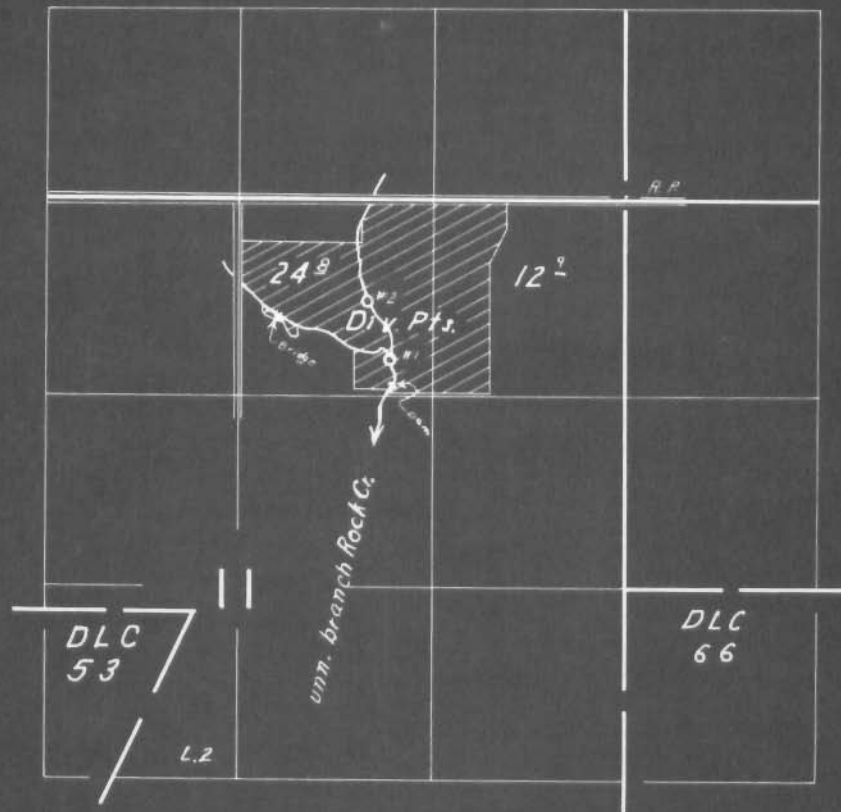

**FINAL PROOF SURVEY**  
UNDER

Application No. *R-29266* Permit No. *R-1637*  
*29267* *23016*  
IN NAME OF

*Carl & Matilda E. Dick*

Surveyed *May 2* 1958, by *R.H. Whitby*