


C-24637  
53612  
T5647

T. 14 S. R. 12 E. W.M.

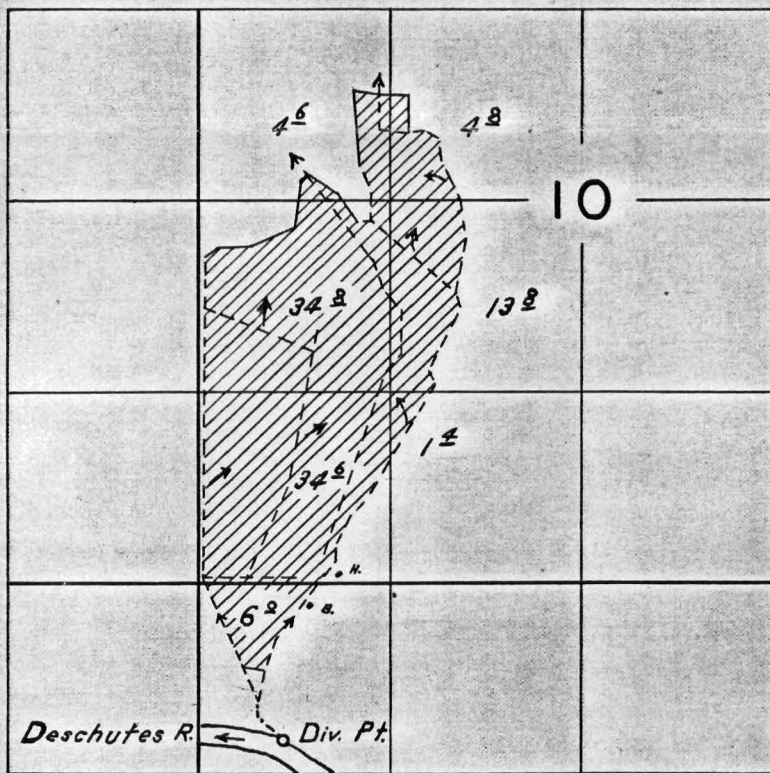

**FINAL PROOF SURVEY**  
UNDER

Application No. 24709 Permit No. 19418  
IN NAME OF

Deschutes Farmers Co-op

Surveyed Oct. 29, 1958, by W.M. Perry