


P. 19430
19719
24638

T.13&14 S. R.31 E.W.M.

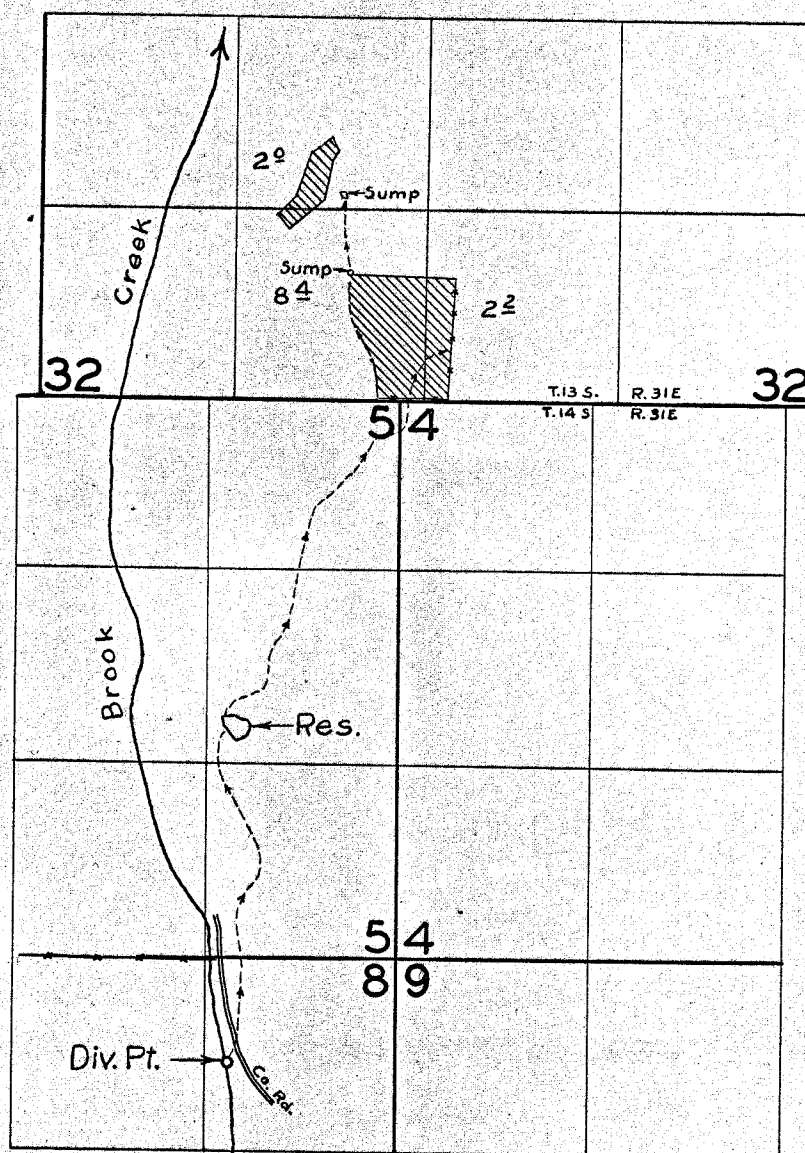

FINAL PROOF SURVEY UNDER

Application No. 25030 Permit No. 19719.....
IN NAME OF

Merle Tracy

Surveyed 22 Sept. 1957, by *Tom Bish*.....