


T.14 S.R.5 W.W.M.

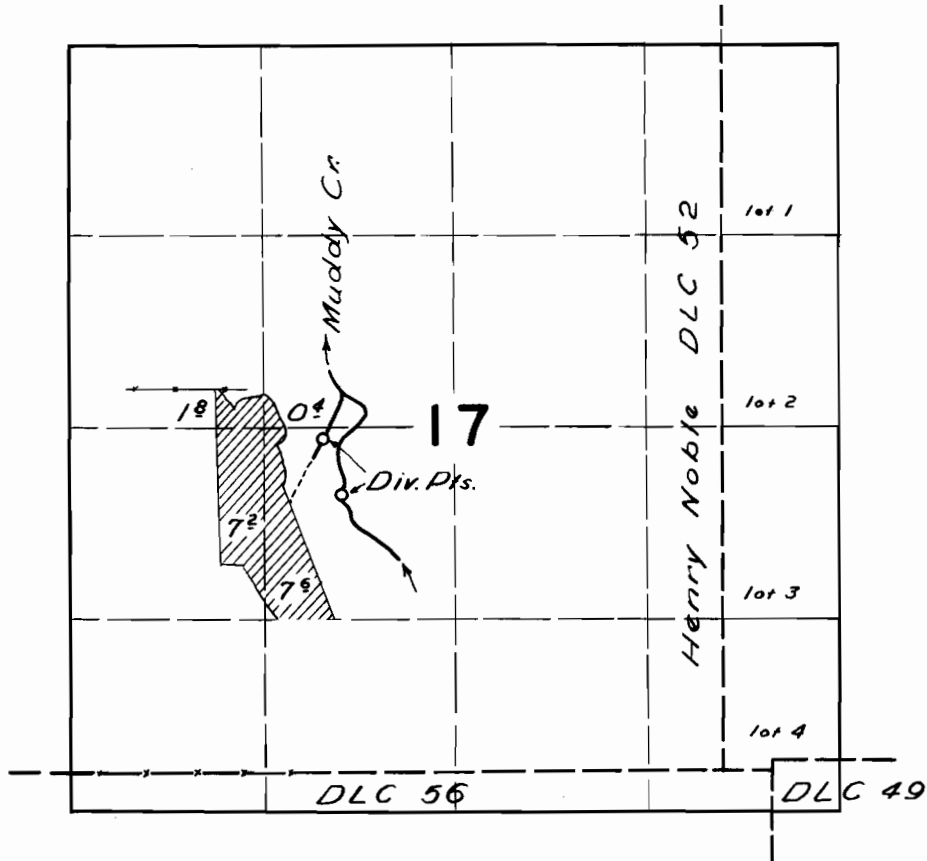

FINAL PROOF SURVEY
UNDER

Application No. 25584 Permit No. 20080
IN NAME OF

ELMER & MABEL ADAMS

Surveyed 24 Sept 1957, by [Signature]