


T. 7 S. R. 3 W. W.M.

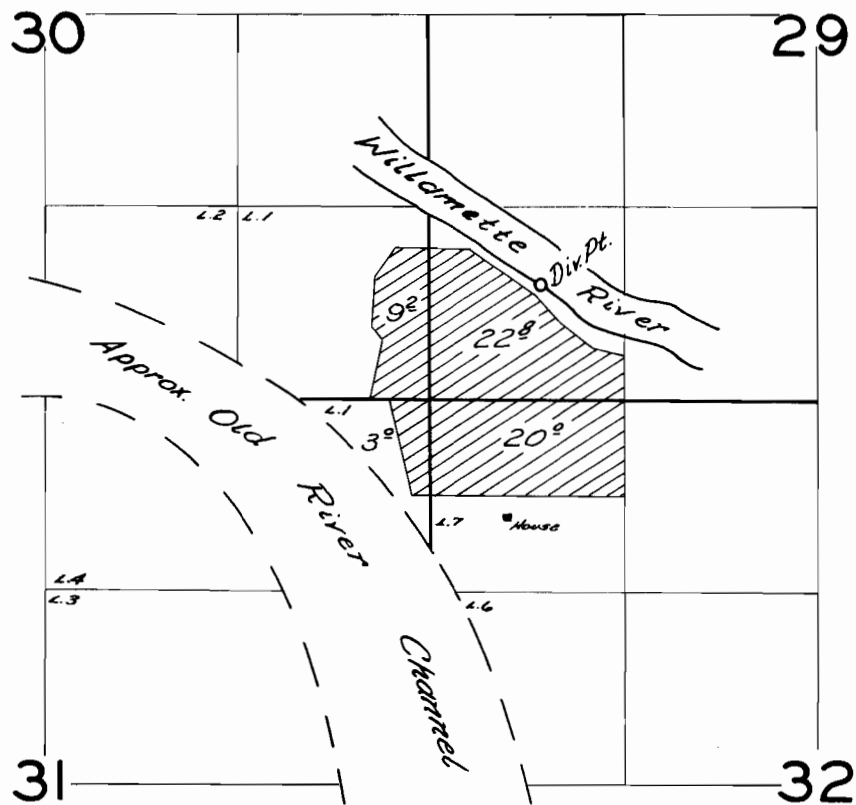


FINAL PROOF SURVEY
UNDER

Application No. *25623* Permit No. *20101*
IN NAME OF

Paul T. Riensche

Surveyed *March 25 1957*, by *C.O. Banta*

T. 7S. R. 3W. W.M.

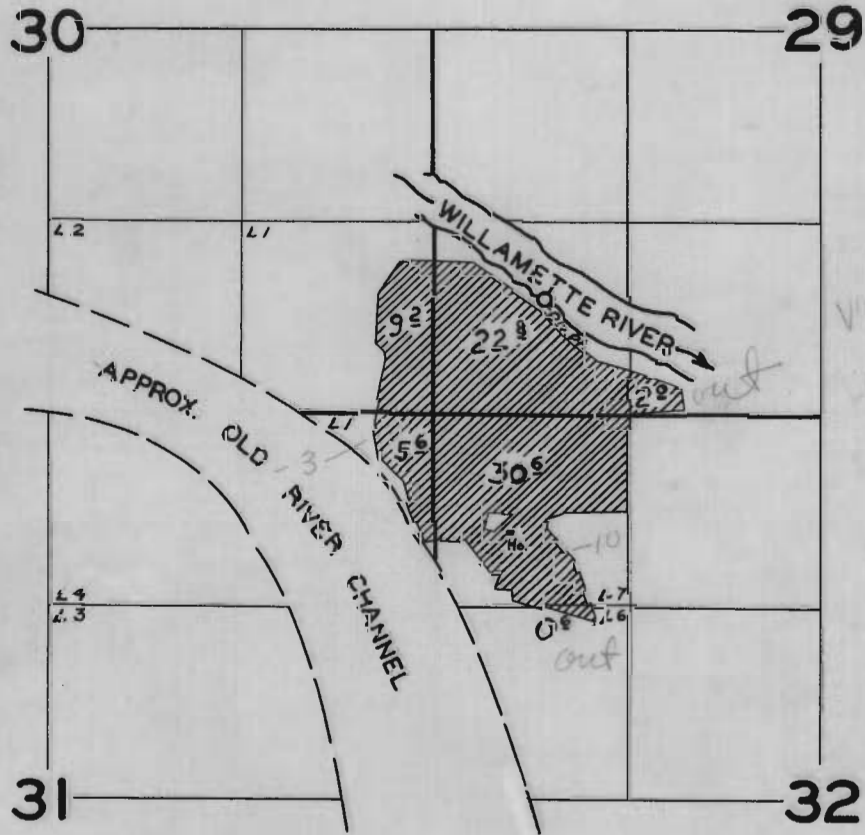

FINAL PROOF SURVEY

UNDER

Application No. 25623 Permit No. 20101

IN NAME OF

PAUL T. RIENSCHKE

Surveyed MAR 25, 1957, by C.O. BARTELS