


20399
24646

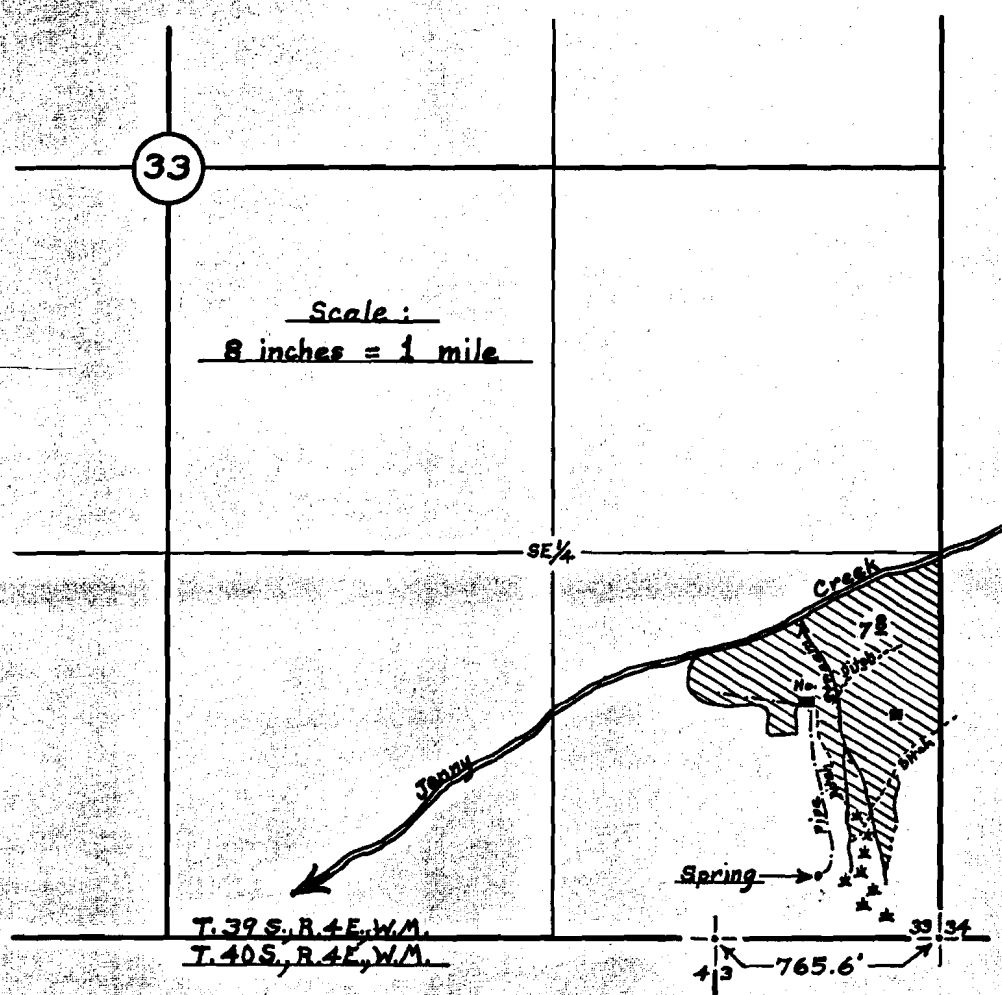

Jenny Creek mead

FINAL PROOF SURVEY UNDER

Application No. 26086 Permit No. 20399
IN NAME OF

Garis J. Flinn

Surveyed 10-21- 1958, by D.C. Hendrix, W.M.

RECEIVED
DEC 1 1958
STATE ENGINEER
SALEM, OREGON