T.8S. R.6 W.W.M.

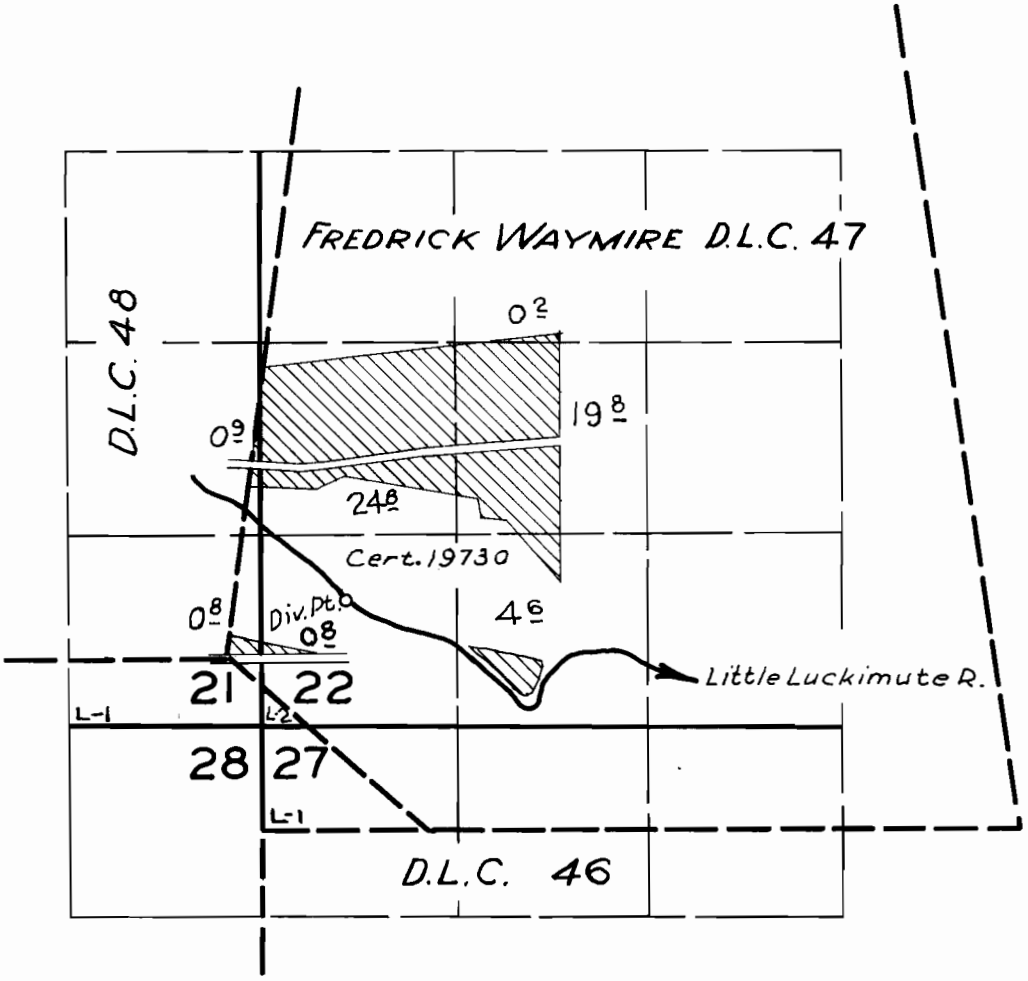

FINAL PROOF SURVEY
UNDER

Application No. 26208 Permit No. 20598
IN NAME OF

ANDY L. GILMORE

Surveyed April 23 1958, by R.H. Whitby

DFP-2 P-47