


T. . R. . W.M.

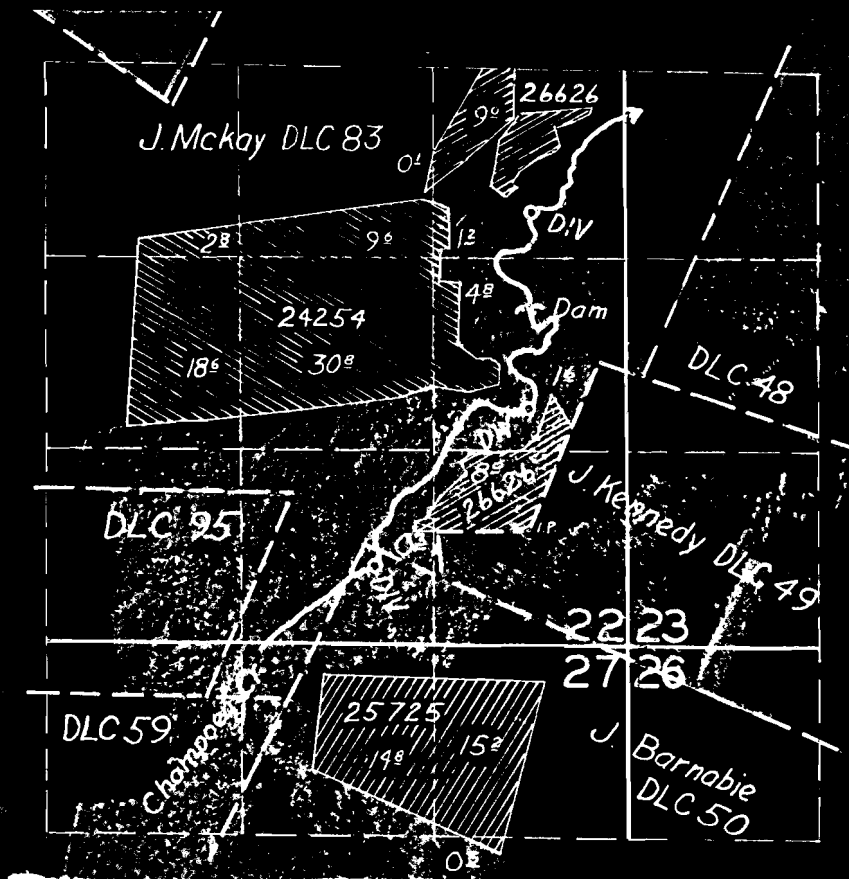


FINAL PROOF SURVEY
UNDER

Application No. Permit No.
IN NAME OF

Surveyed 19 by

T. 4 S., R. 2 W., W.M.

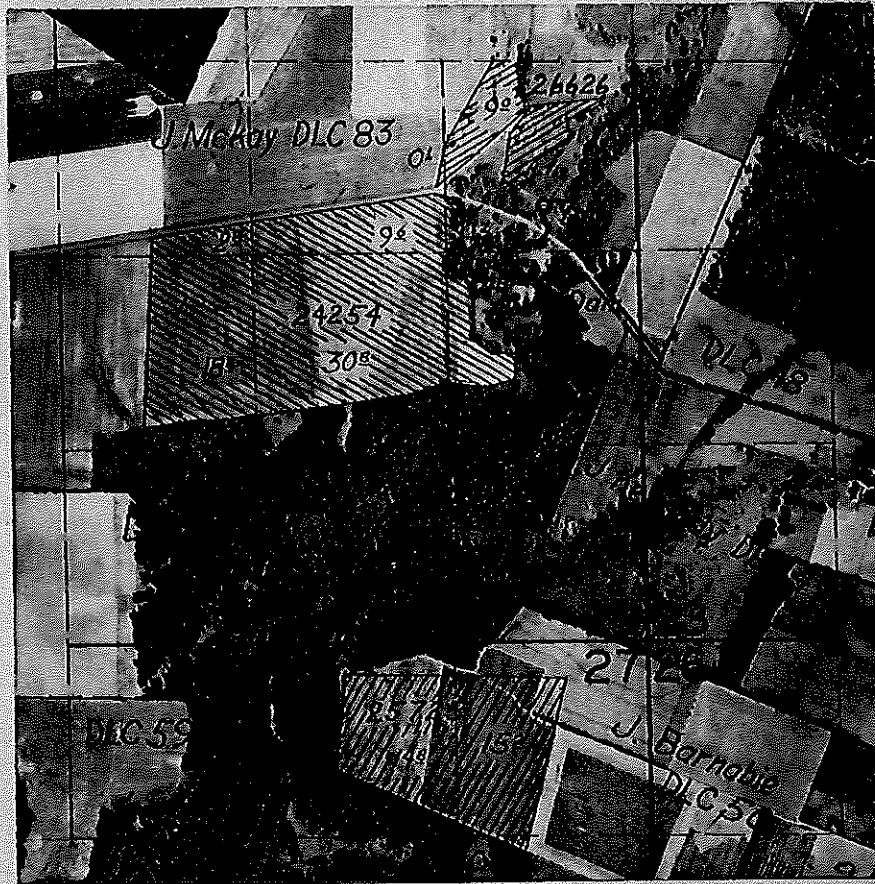

FINAL PROOF SURVEY

UNDER

Application No. 26626..... Permit No. 20850.....

IN NAME OF

Newton Davis
George Settemeyer
George Stittmeyer.....

Surveyed April 13 1954, by H. L. Coffman.

DEM 20 81

T. 4 S., R. 2 W., W.M.



FINAL PROOF SURVEY

UNDER

Application No. 26626 Permit No. 20850.....

IN NAME OF

Newton Davis
George Sattelmeyer
George Sattelmeyer

Surveyed April 13 1954, by H. L. Coffman.

DEM 20 81