


T.41 S.R.13 W.W.M.

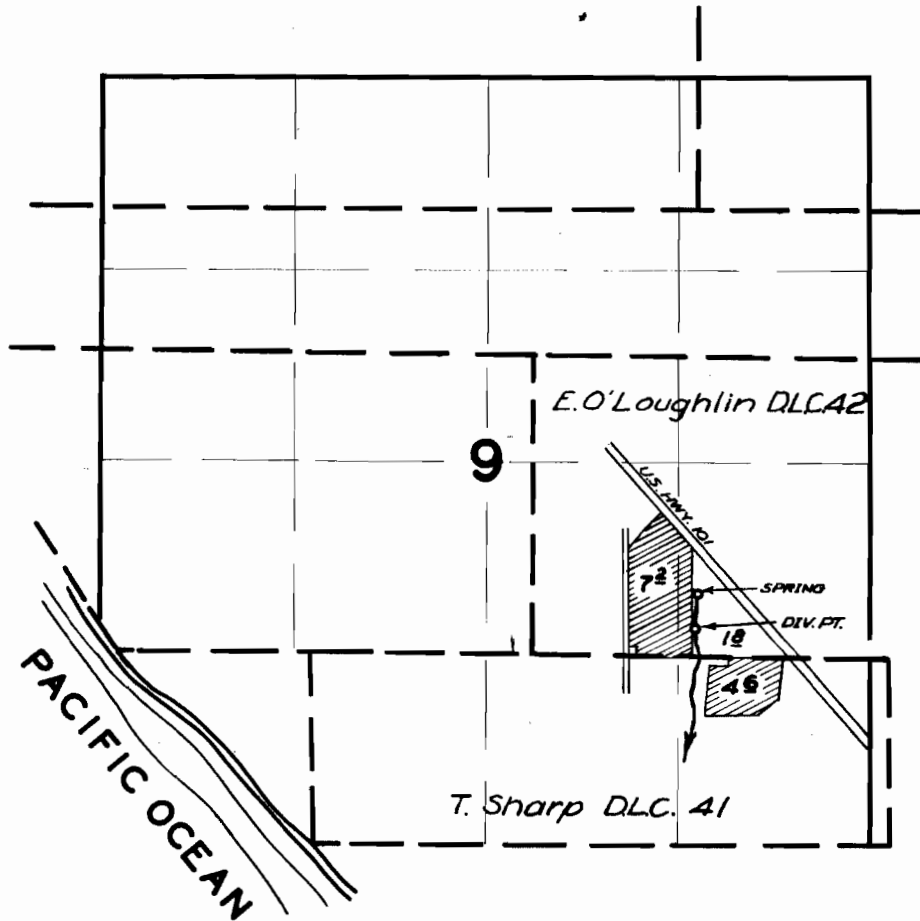

FINAL PROOF SURVEY
UNDER

Application No. 26721 Permit No. 20912
IN NAME OF

Gertrude Cole

Surveyed Mar. 22 1958, by T. Bish