


# T.6S.R.7 W.WM

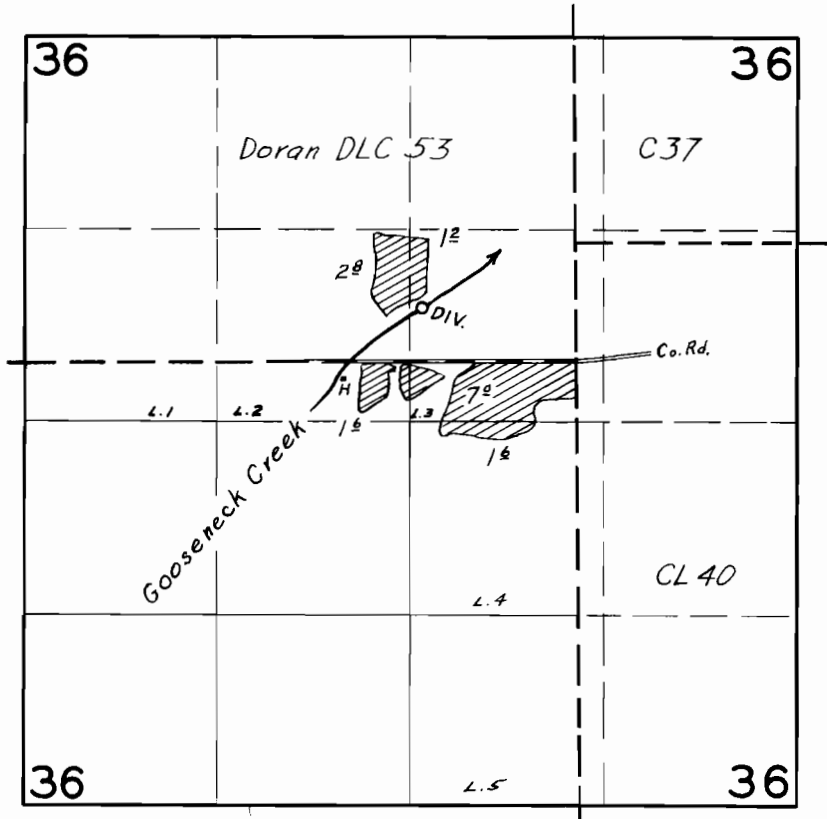

## FINAL PROOF SURVEY

UNDER

Application No. 26589 Permit No. 21256

IN NAME OF

Donald Shenk

Surveyed Aug. 20 1954, by T. Jones