


# T.34-35S. R.9E.W.M.

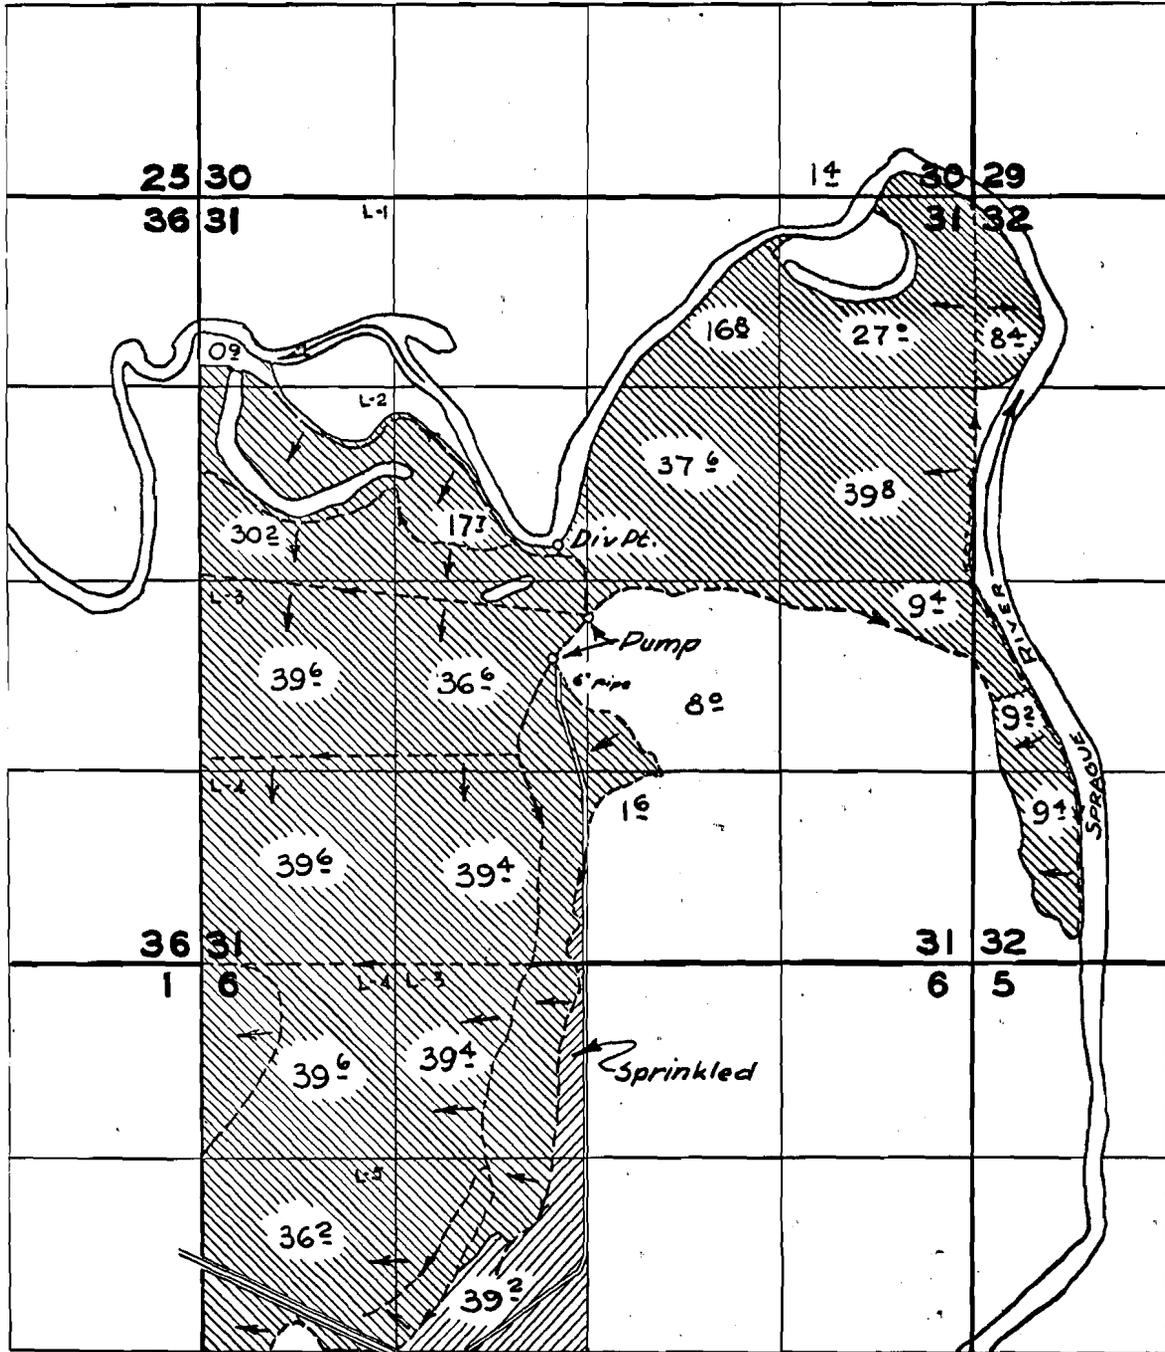

Sprague River

## FINAL PROOF SURVEY UNDER

Application No. 26915... Permit No. 21150.  
IN NAME OF

### HENRY G., J.W. & GERALD C. WOLFF

Surveyed 2 July, 1958, by C.O. Bartels