


T. 3N. R. 5W. W.M.

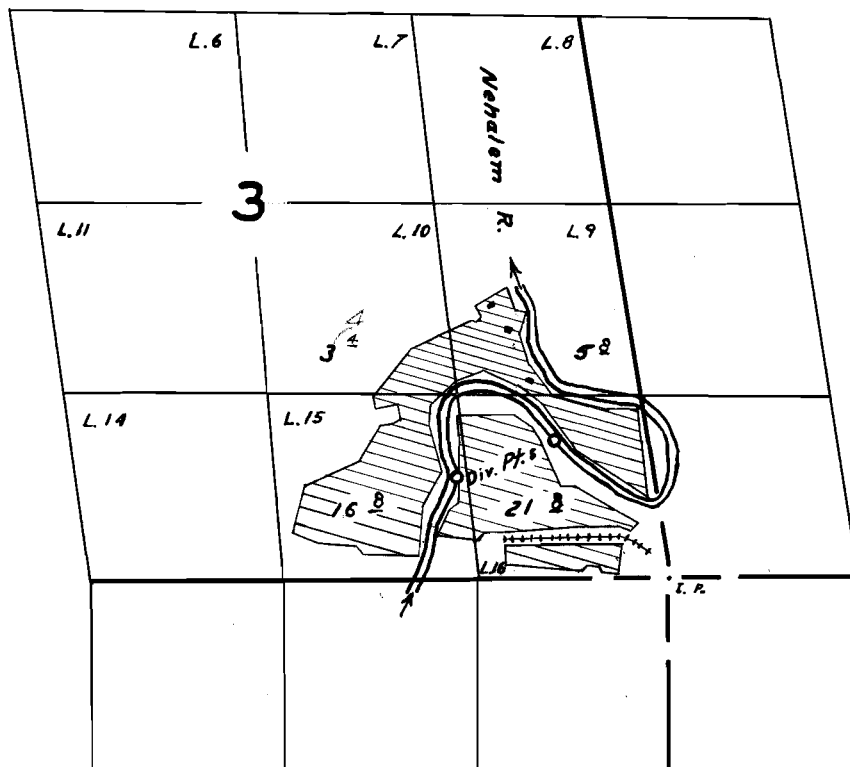

FINAL PROOF SURVEY
UNDER

Application No. 27638 Permit No. 21769
IN NAME OF

Joe Baker

Surveyed May 1 1958, by R. H. Whitby