


T. 6N. R. 35E. W.M.

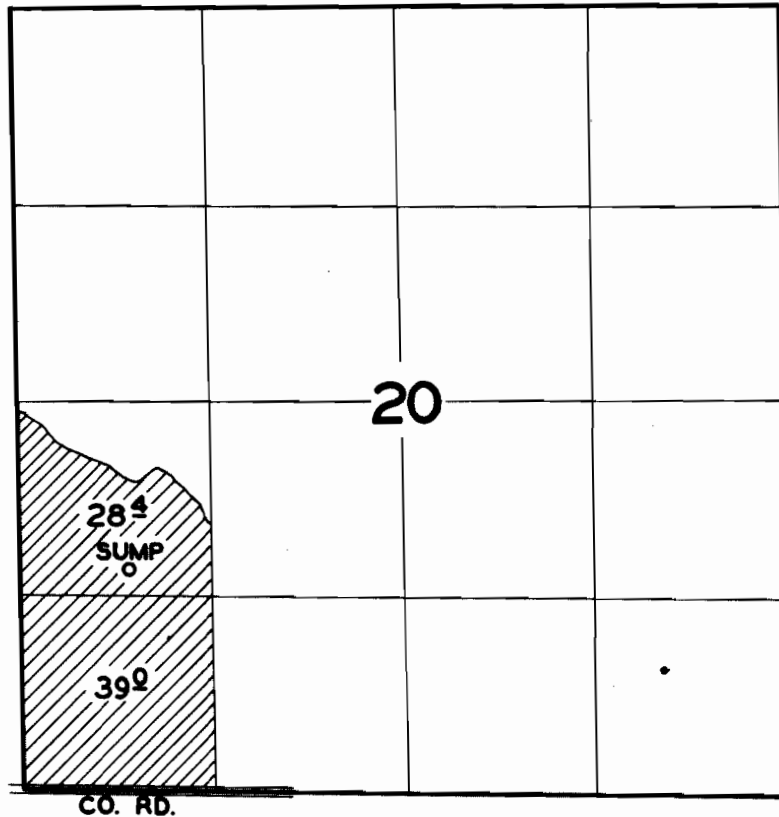

FINAL PROOF SURVEY
UNDER

Application No. 27897 Permit No. 21827
IN NAME OF

PHIL MURPHY

Surveyed JUNE 4 1957, by C.O. Bartleb