


T. 38 S., R. 4 W., W.M.

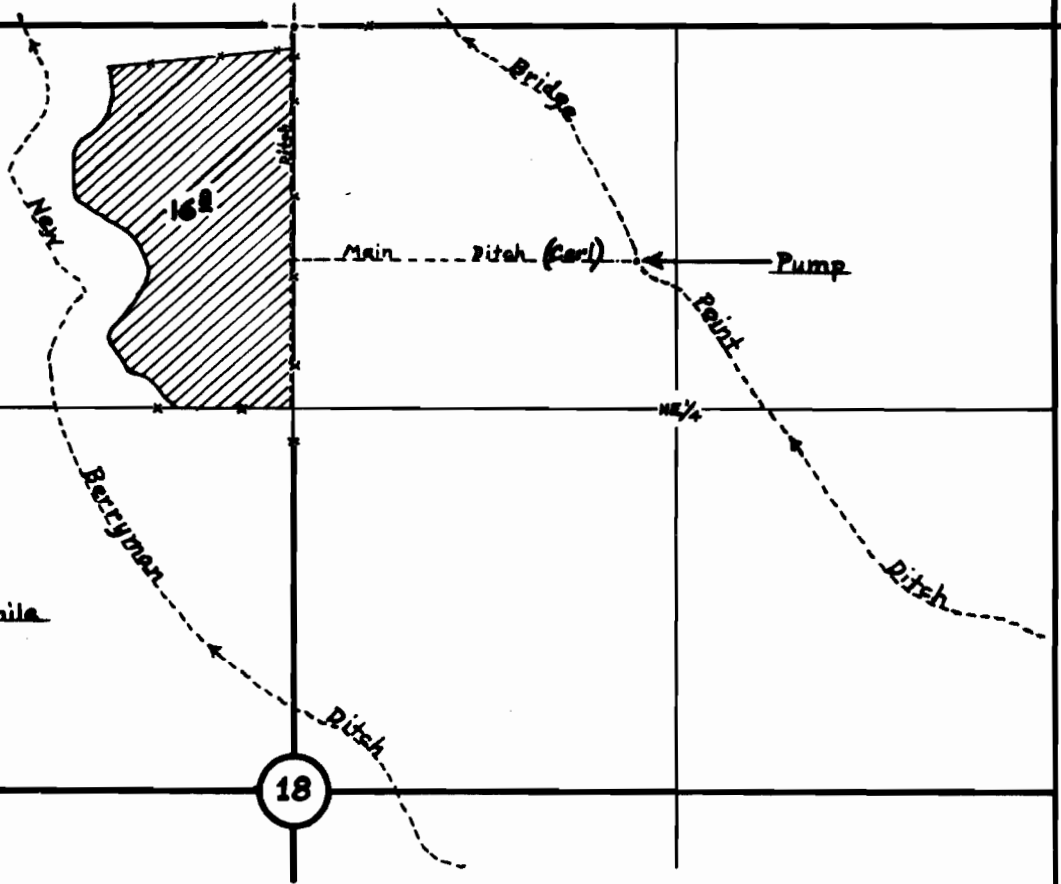

Scale: 8 inches = 1 mile

FINAL PROOF SURVEY
UNDER

Application No. 27982 Permit No. 22025
IN NAME OF

.....William N. Carl.....

Surveyed Nov. 28, 1958., by D.C. Hendrix, W.M.