


T.6 S. R.6 W.W.M.

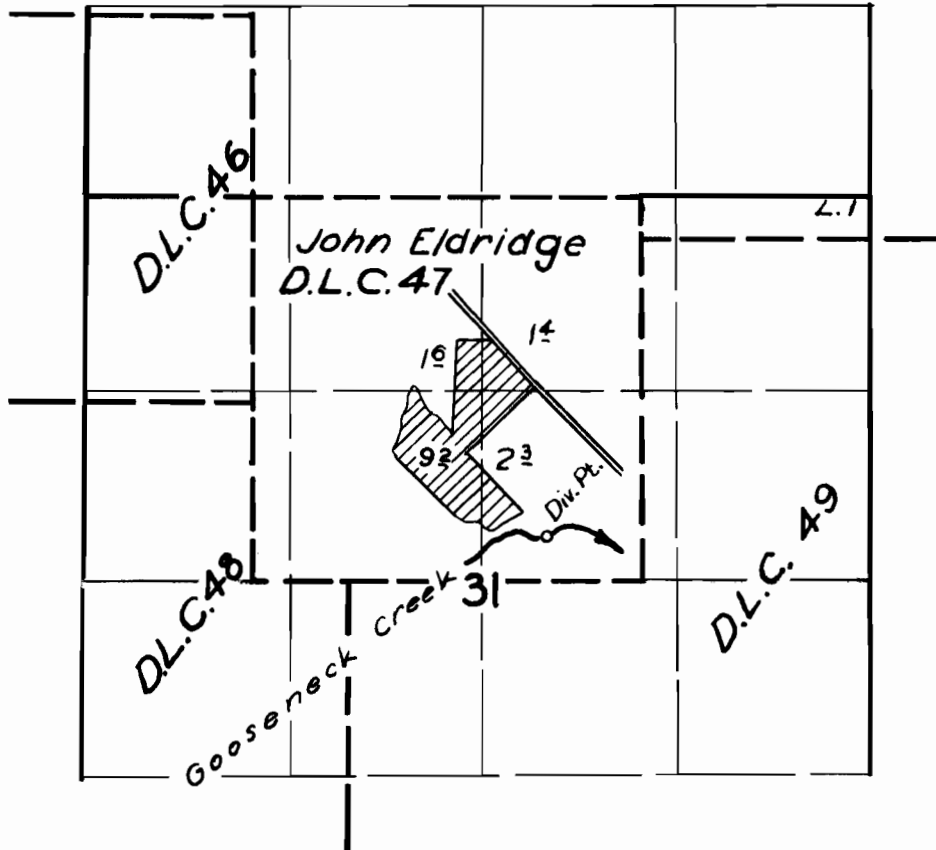

FINAL PROOF SURVEY
UNDER

Application No. 27406 Permit No. 22422
IN NAME OF

ENOS H. SCHROCK

Surveyed April 4, 1958, by R.H. Whitby