


T.8S. R.5 W.W.M.

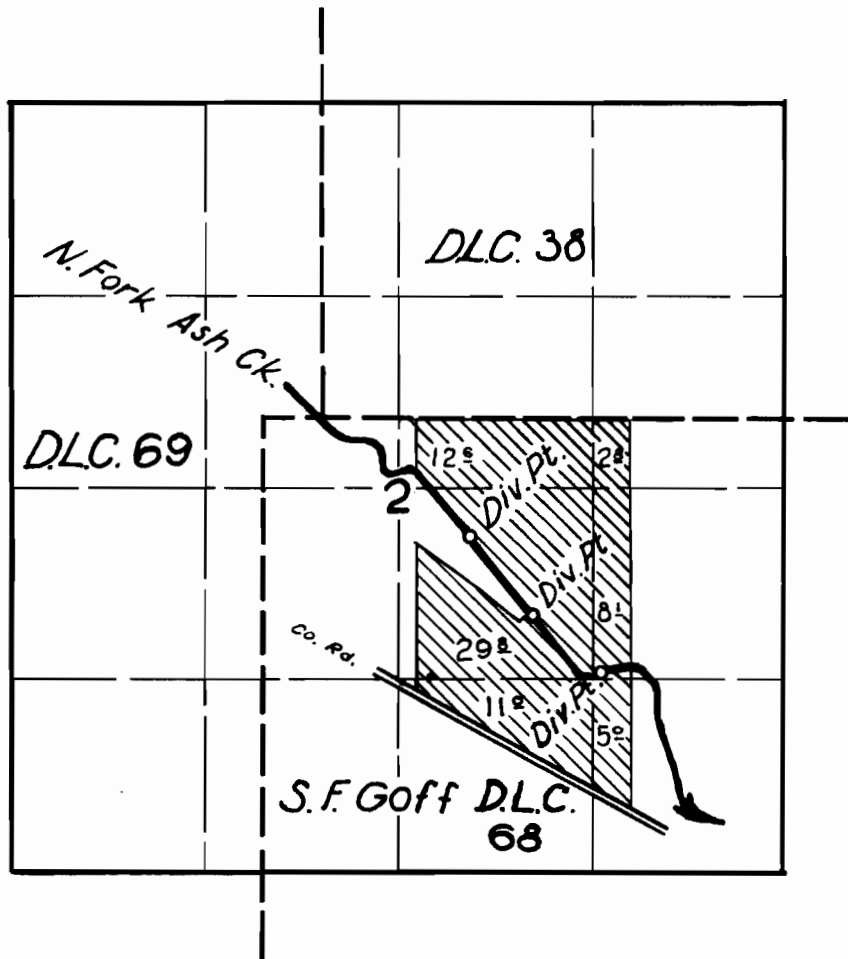

FINAL PROOF SURVEY
UNDER

Application No. 26047. Permit No. 23222.
IN NAME OF

FRANK NEUFELD

Surveyed April 2, 1958, by R.H. Whitby