


T. 2 N., R. 33 E., W.M.

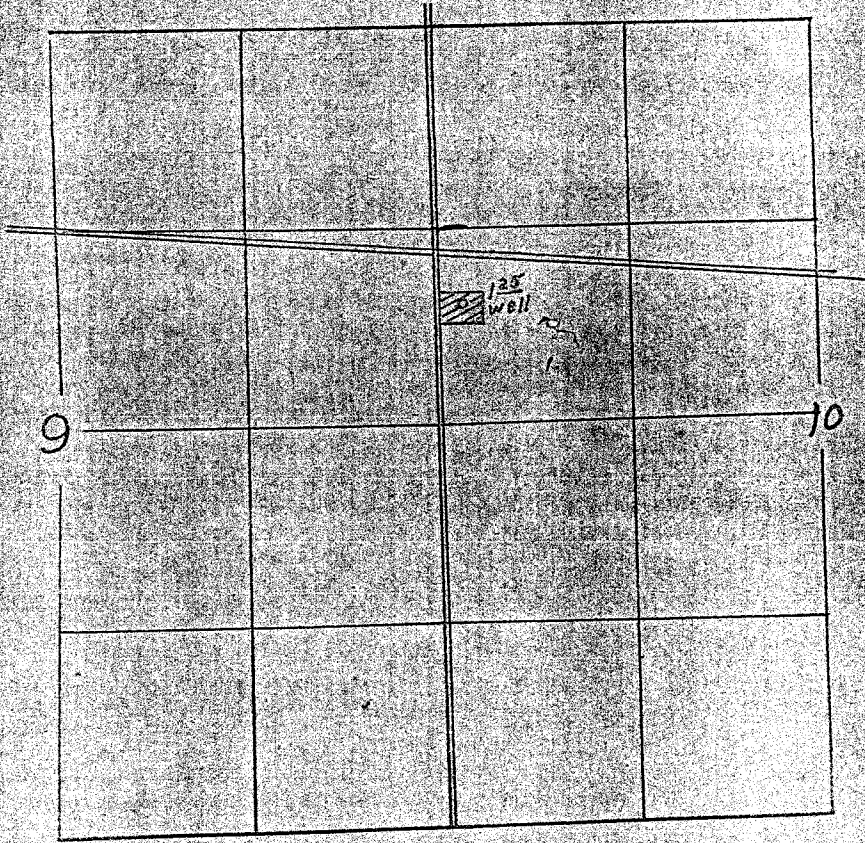

Application No. U-308 Permit No. U-347