


T.35S. R.7 E.W.M.


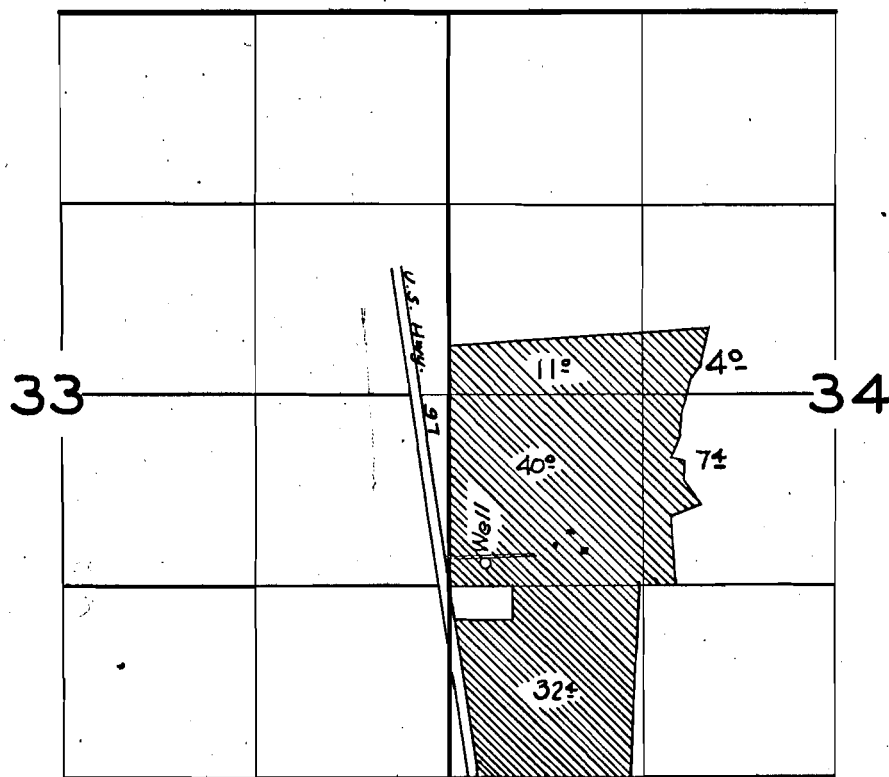

FINAL PROOF SURVEY UNDER

Application No. U-386... Permit No. U-357... IN NAME OF

MRS. ELSIE BURTON

Surveyed 24 June 1958, by C.O. Bartels