


Sketch  
To accompany Water Application of  
FRANK S RILEY  
Situate in Sections 5, 8 & 9 T38S, R10E  
Klamath County, Oregon  
Scale 8" = 1 Mile  
Sept. 17, 1951.

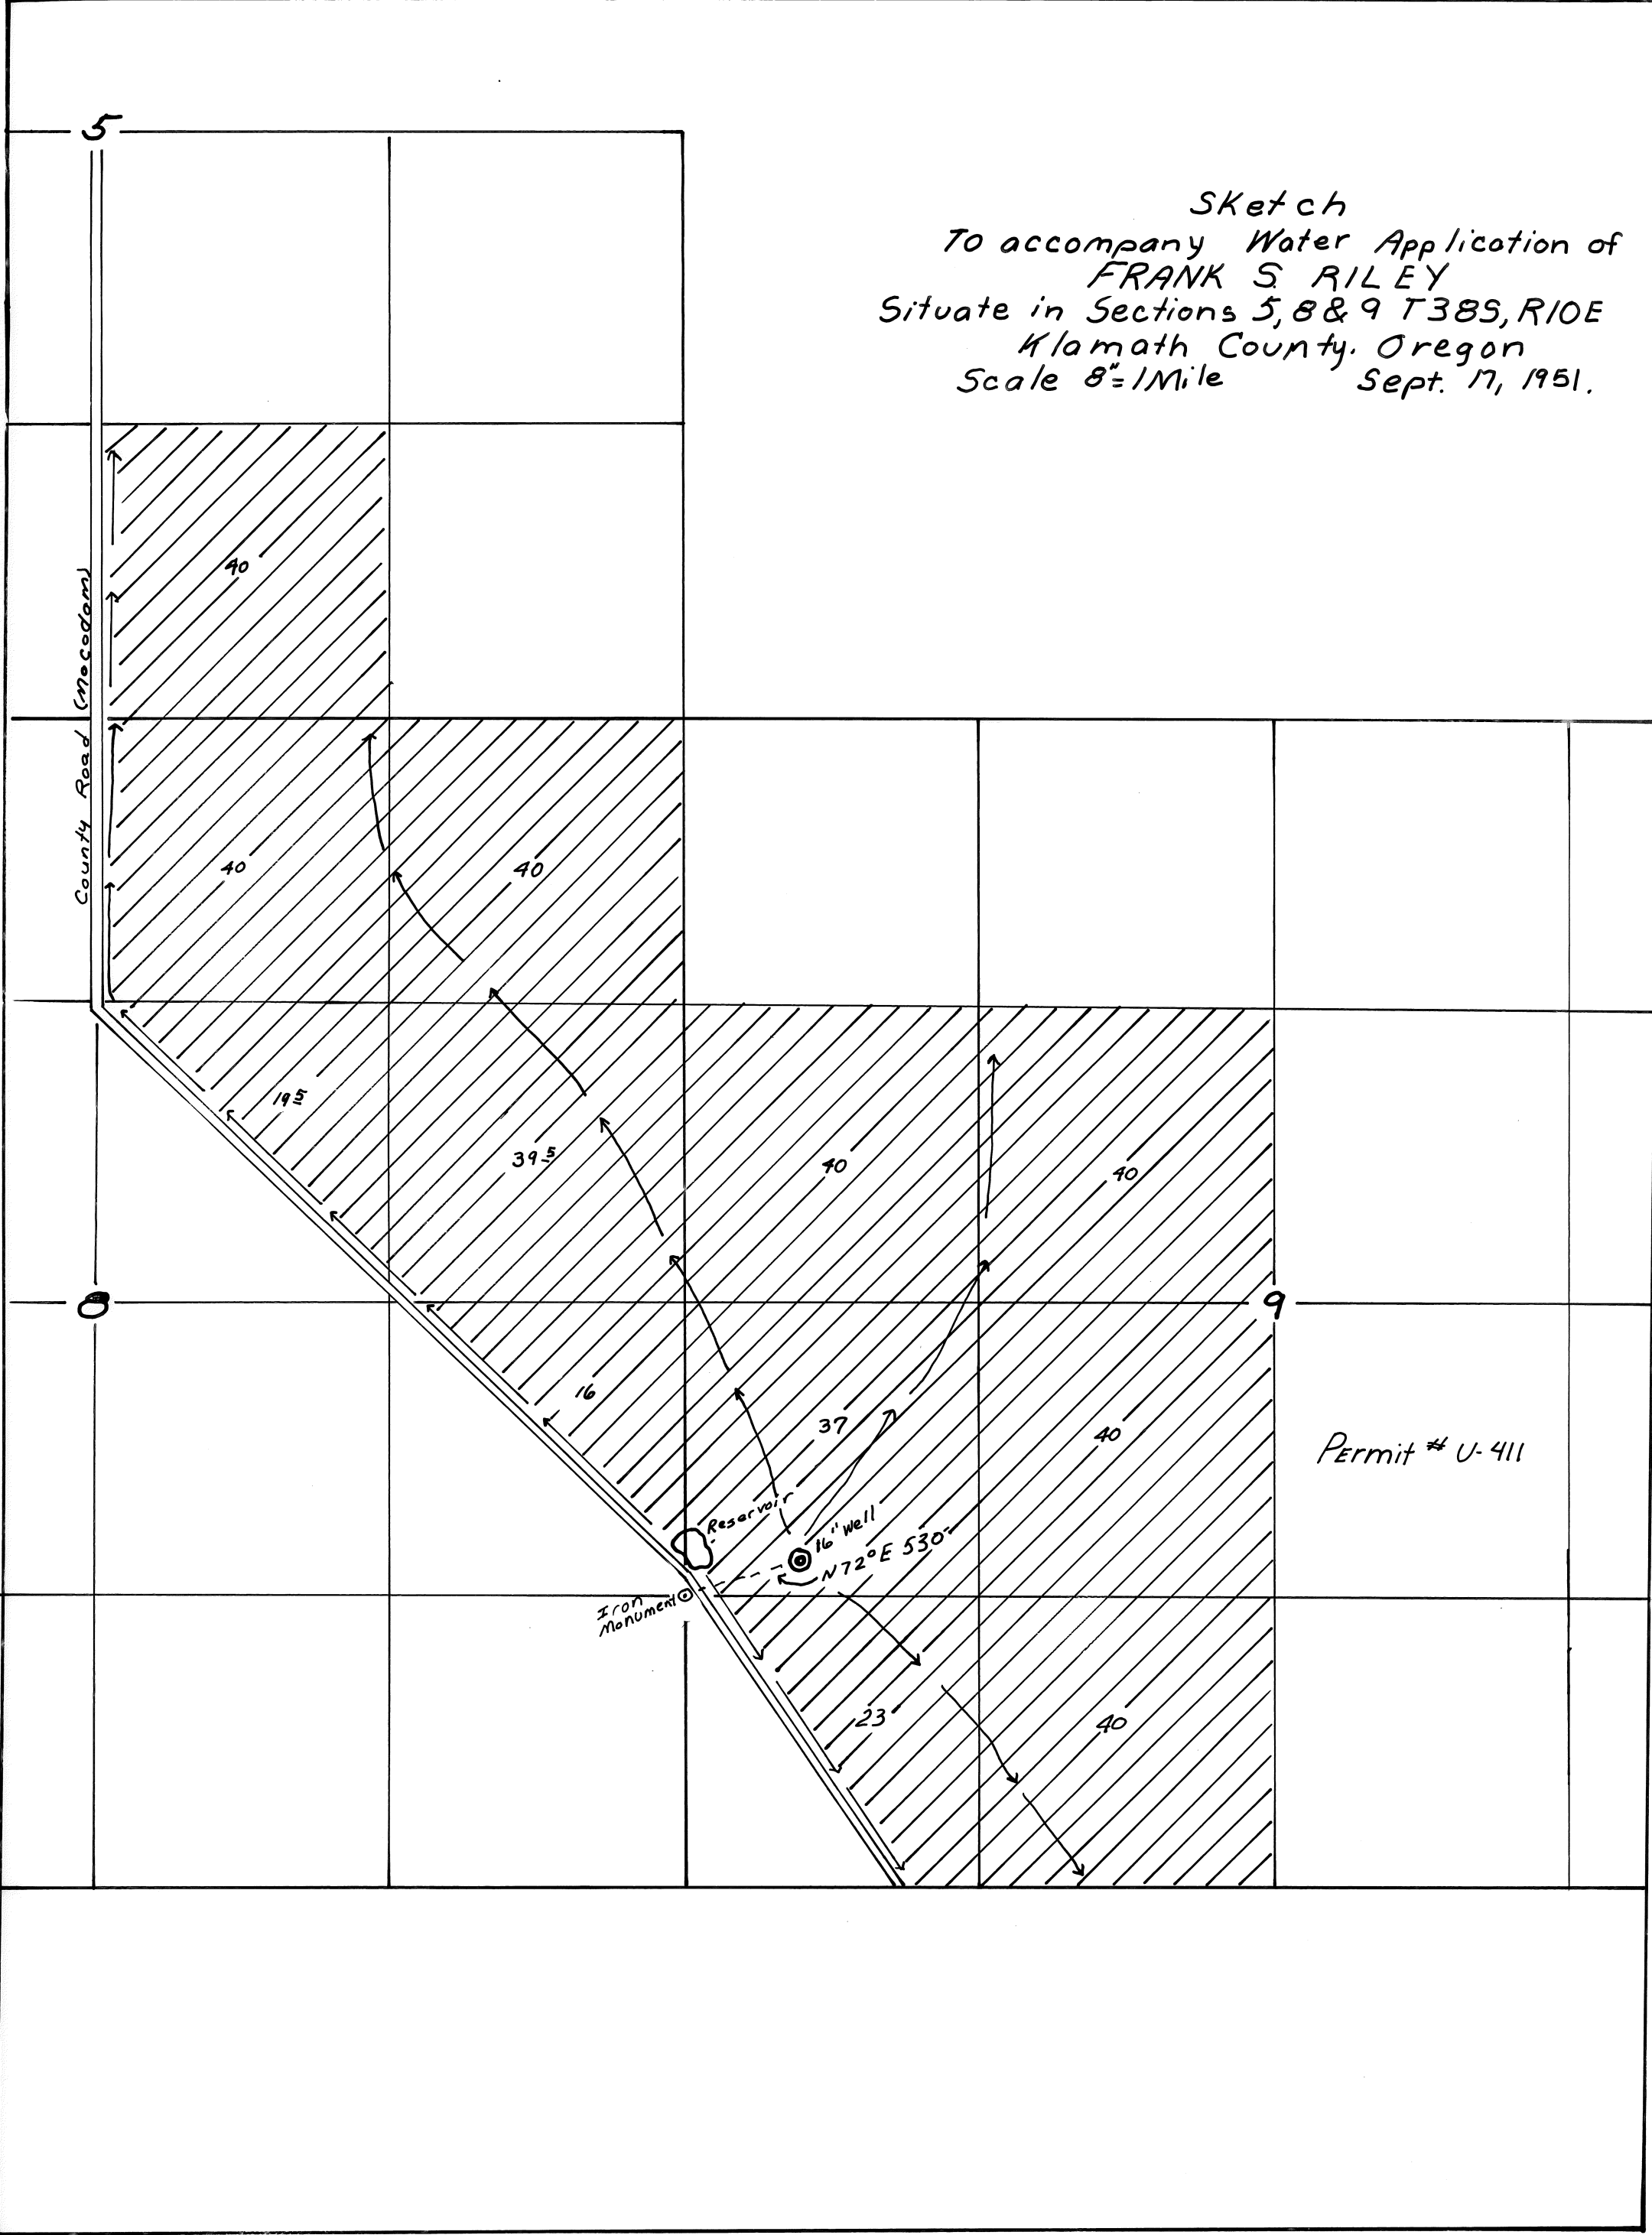

Permit # U-411