


U-444
C-24680

T. 3N., R. 29E., W.M.

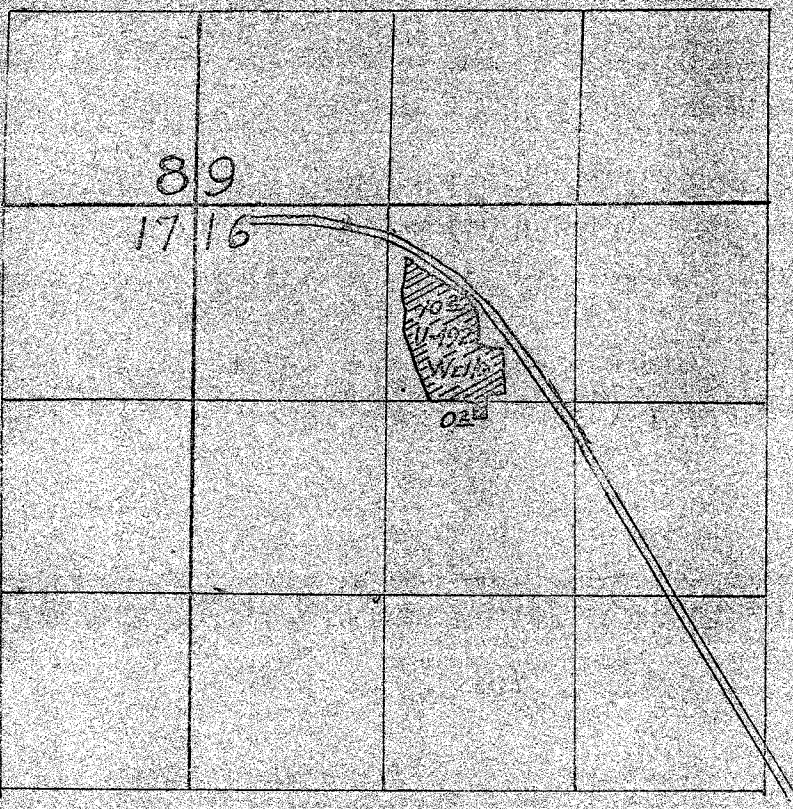

Application No. U-492 Permit No. U-444

NZ 25-75