


T.6N.R.34E.W.M.

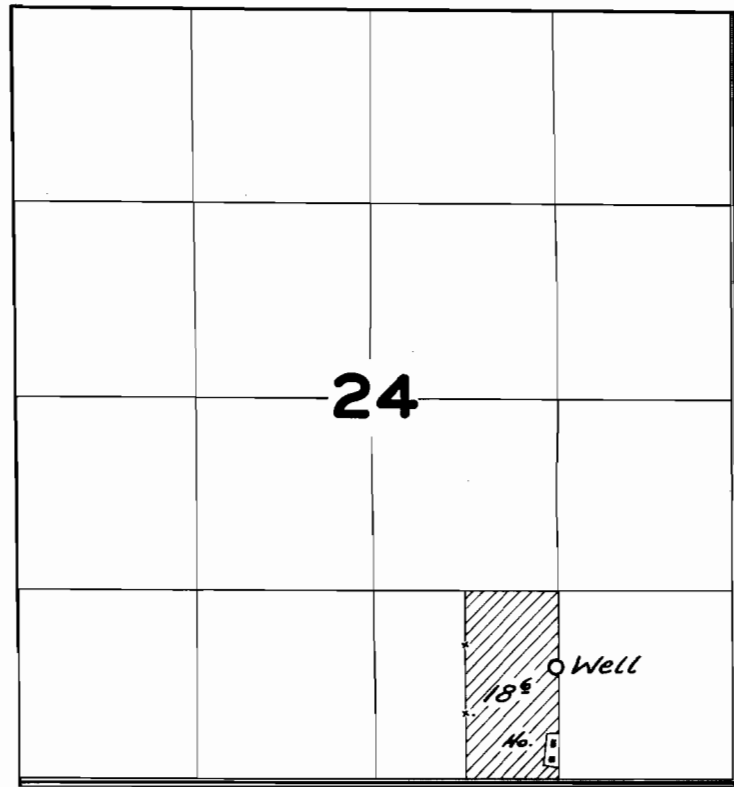

**FINAL PROOF SURVEY**  
UNDER

Application No. *U-503* Permit No. *U-458*  
IN NAME OF

*Frances Fitzsimmons*

Surveyed *May 17, 1954*, by *H.L. Coffman*