


# T. 2N. R. 32E.W.M.

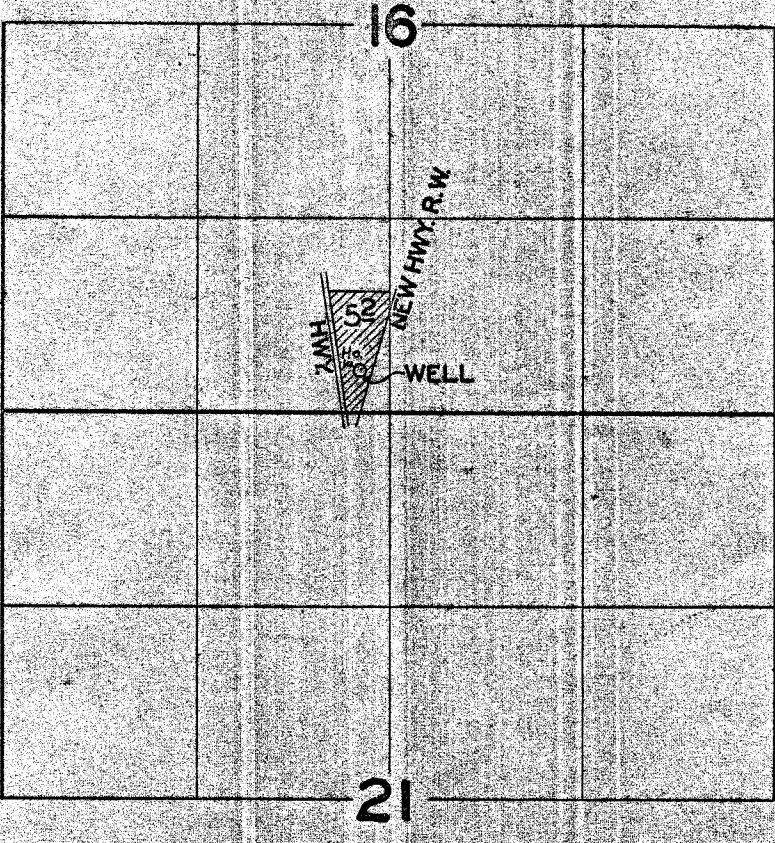

## FINAL PROOF SURVEY UNDER

Application No. U-726 Permit No. U-644  
IN NAME OF .....

NEAL & HAZEL RIDDLE

Surveyed MAY 16 1957, by C.O. Smith