


TOWNSHIP 12S RANGE 5W W.M.

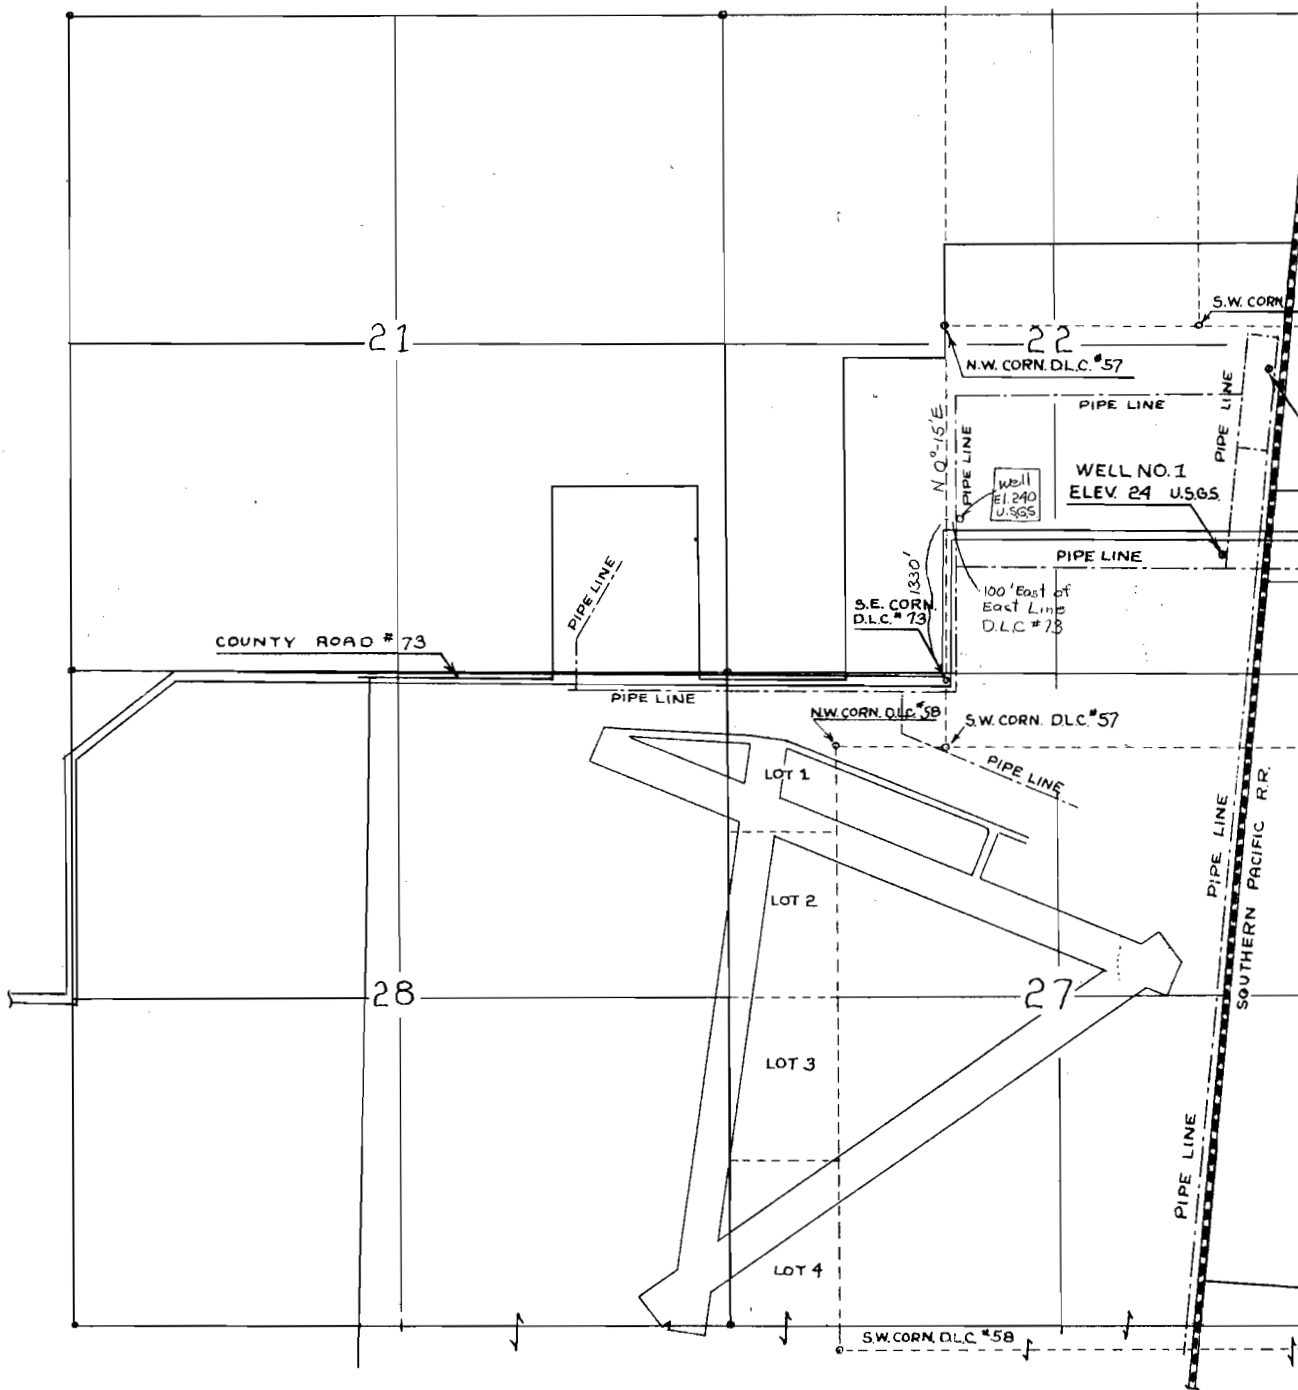

RECEIVED
JUN 20 1956
CORVALLIS, OREGON

CORVALLIS MUNICIPAL AIRPORT
LOCATION OF WELLS FOR STATE REGISTRATION
SCALE = 1000' / INCH

Application No. G-
Permit No. G-1