


T.38&39S. R.10&11 1/2 E.W.M.

Scan Lake Wells

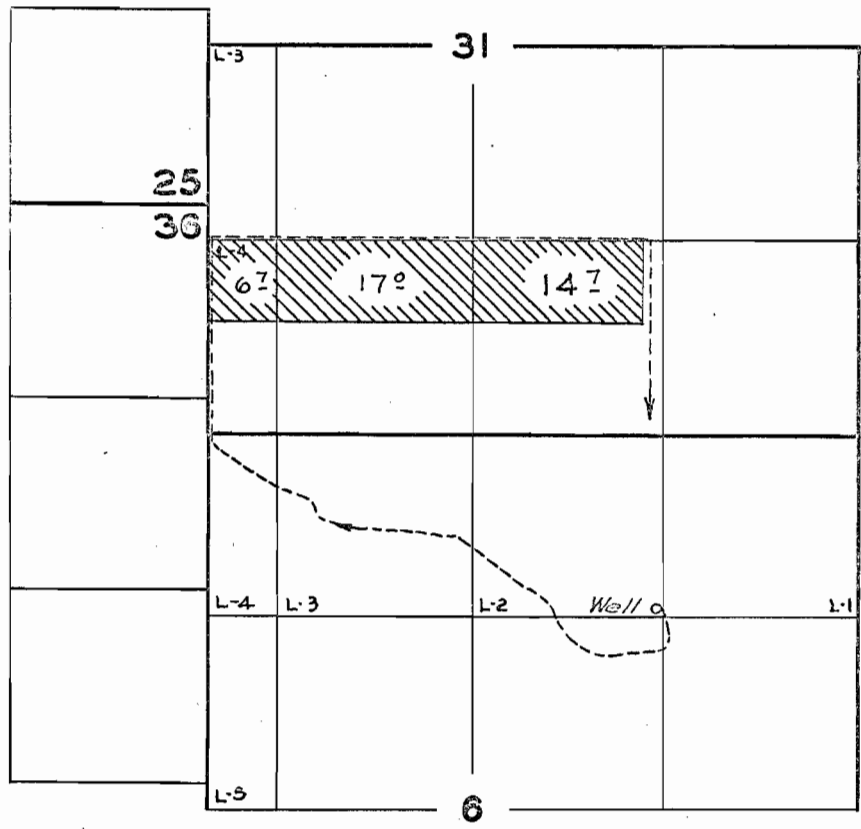

FINAL PROOF SURVEY UNDER

Application No. G-550 Permit No. G-468. IN NAME OF

EVERETT E. METLER

Surveyed 1 July 1958, by C.O. Bartels