


	15			14				13	
	22			23				24	
	27			26				25	
	34			35				36	

FROM OFFICE OF THE STATE ENGINEER, SALEM, OREGON

Willow Creek Adjudication

3 S. 26 E.

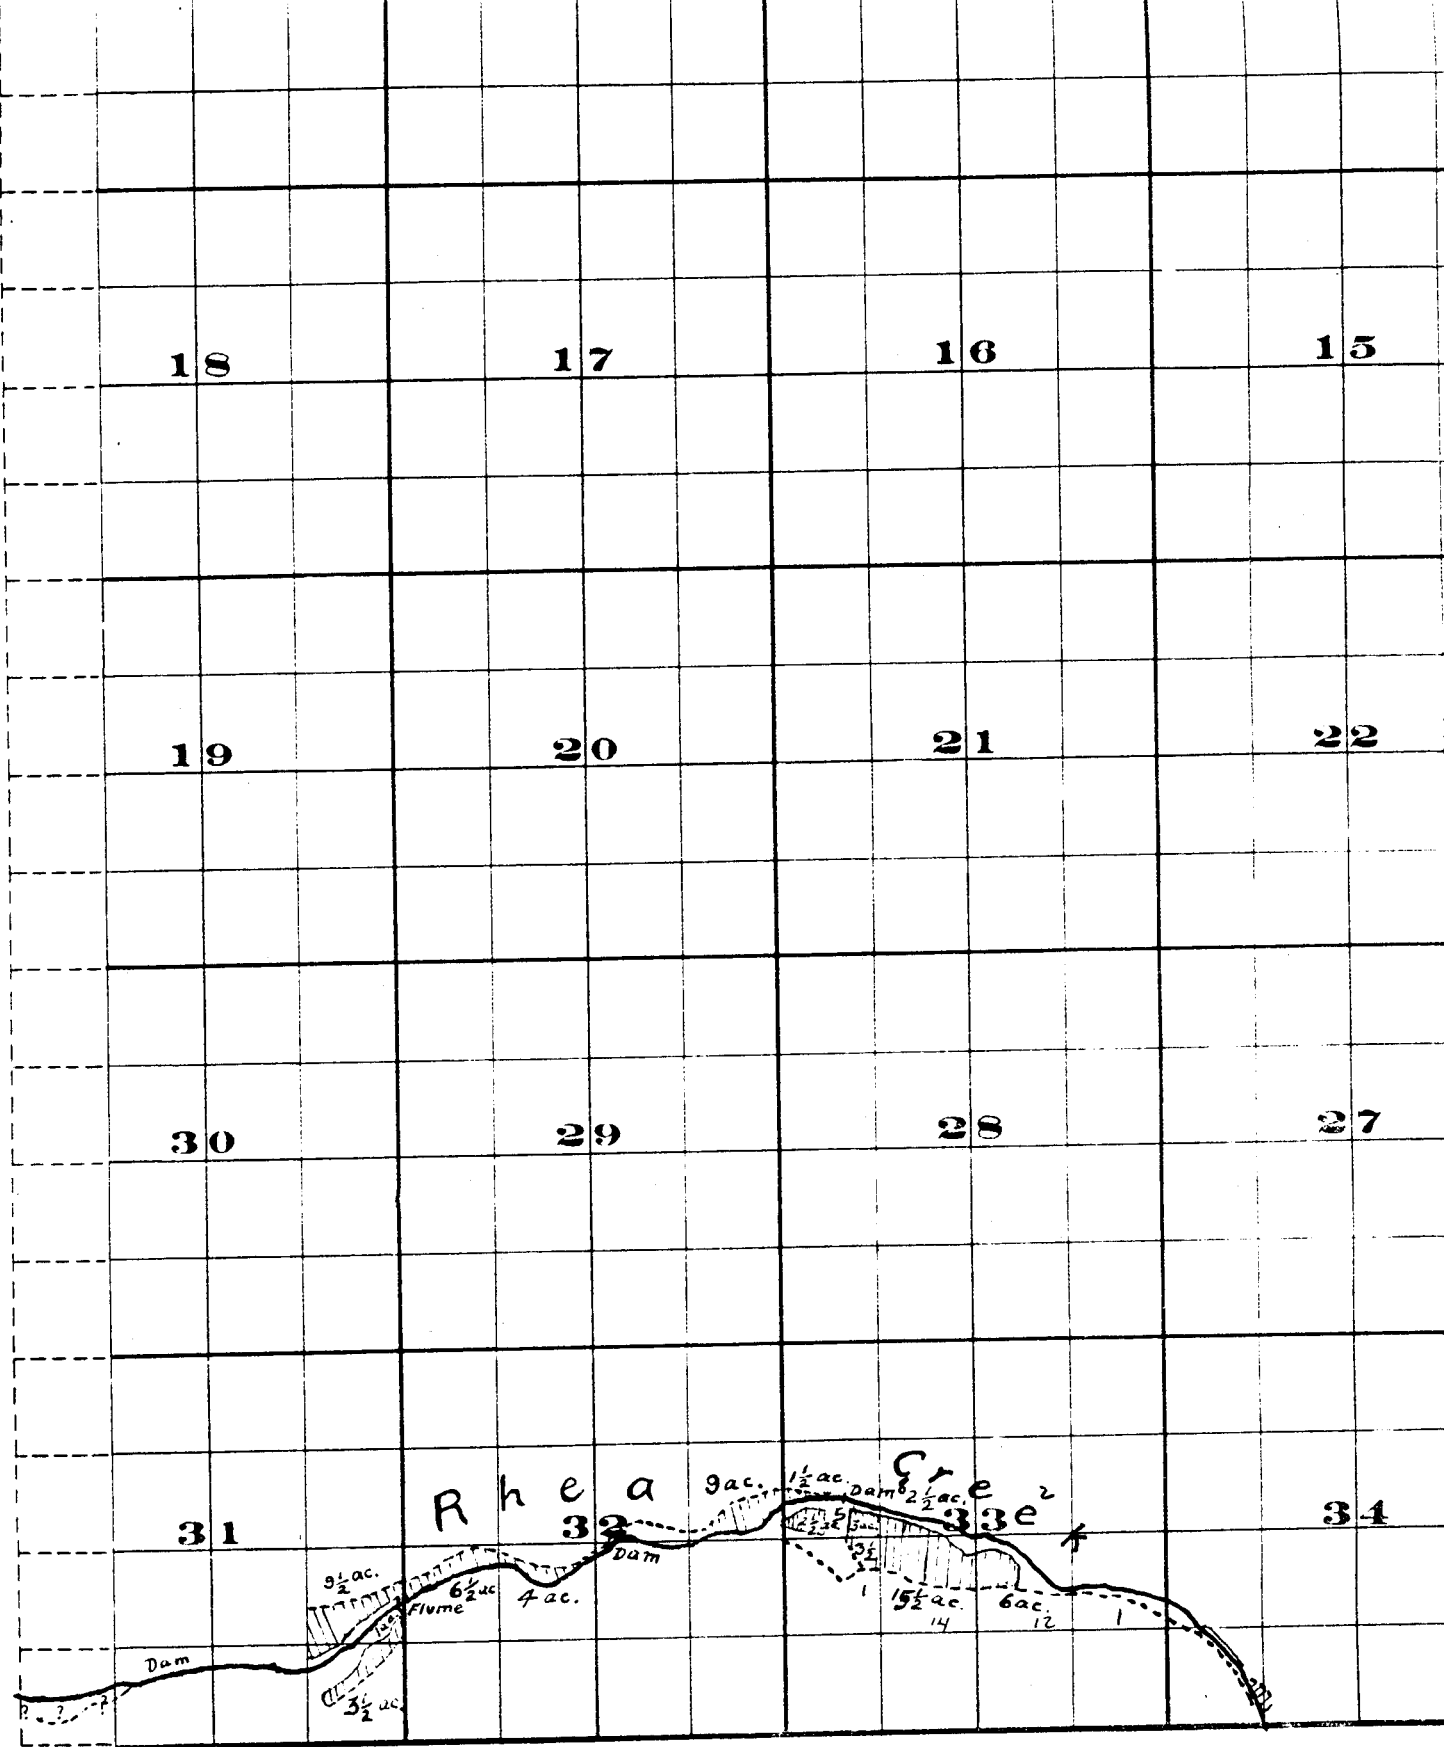

THE S. B. STOL CO. PRINTERS & BOUNDERS CHICAGO, ILL.

Surveyed by H. M. Donnelly July 1909

John H. Lewis - State Engineer

Examined - July 14, 1909.

